


15760 VENTURA

ENCINO GATEWAY

SUITE 100 | 3,576 RSF

SHERMAN OAKS/ENCINO

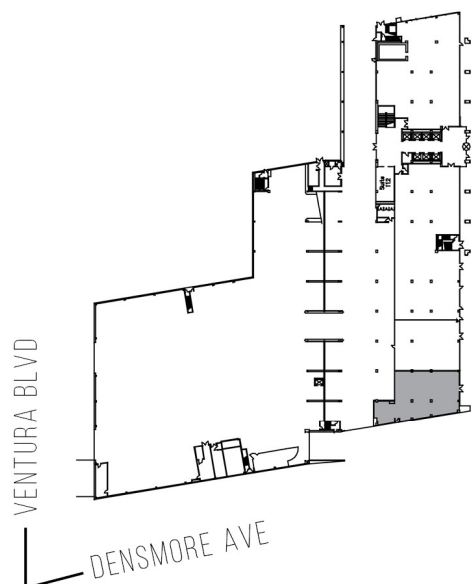

AS-BUILT CONFIGURATION

OFFICES:	8
RECEPTION:	1
CONFERENCE ROOM:	1
KITCHEN:	1
RESTROOM:	1
STORAGE:	2

NOT TO SCALE
FURNITURE NOT INCLUDED

For more information, please contact:

310.255.7777
leasing@douglasemmett.com

**Douglas
Emmett**