
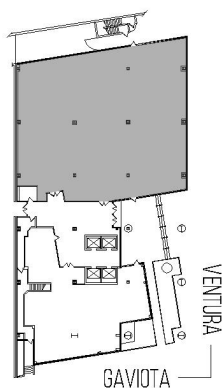


16000 VENTURA

SUITE 100 | 8,773 RSF

SHERMAN OAKS/ENCINO

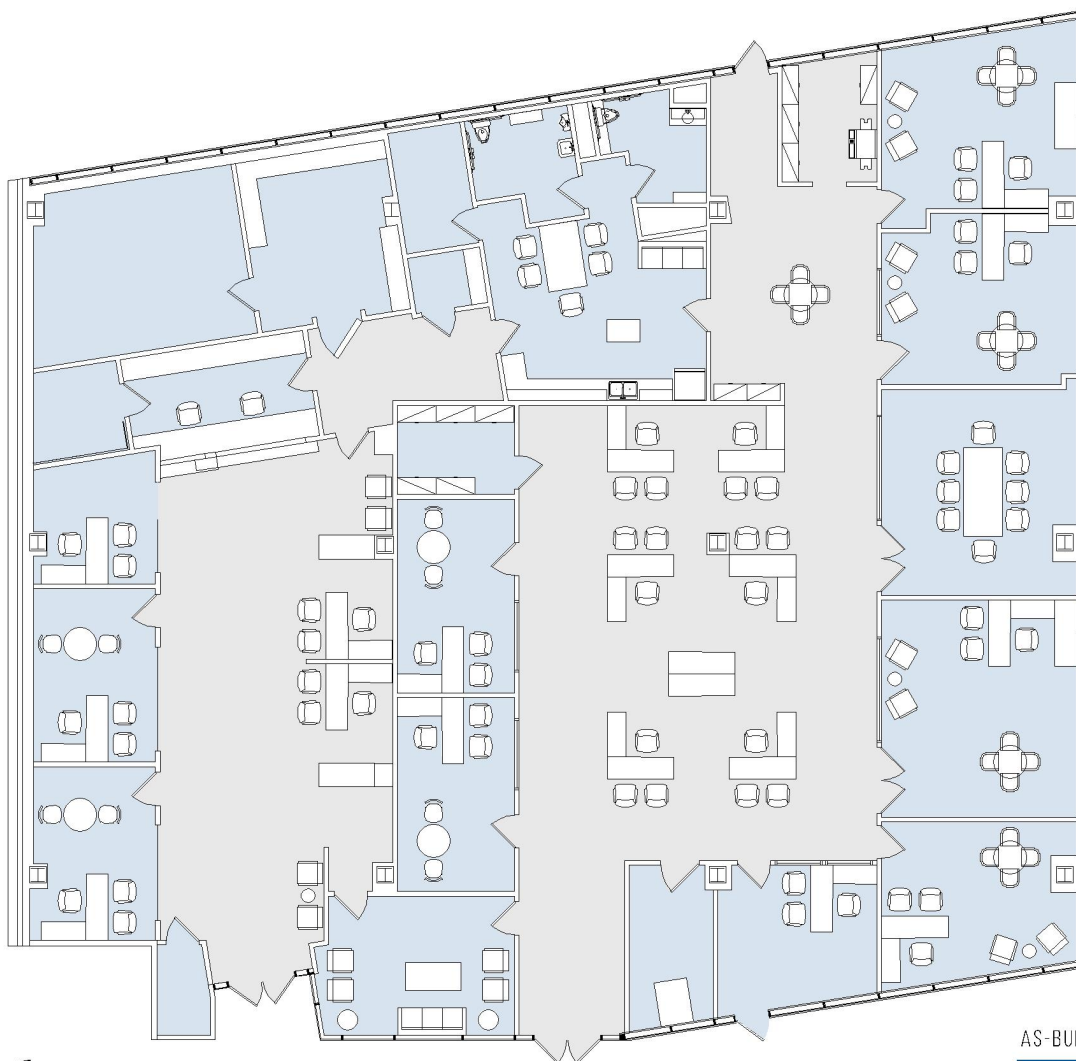

AS-BUILT CONFIGURATION

EXECUTIVE OFFICES:	10
CONFERENCE ROOM:	1
RECEPTION:	1
KITCHEN:	1
PRIVATE BATHROOMS:	2
STORAGE:	5
WAITING ROOM:	1

NOT TO SCALE
FURNITURE NOT INCLUDED

For more information, please contact:

310.255.7777
leasing@douglasemmett.com

**Douglas
Emmett**