
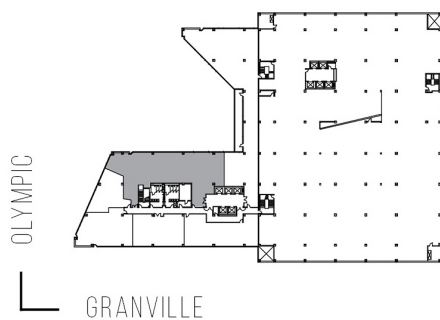


11835 OLYMPIC

WESTSIDE TOWERS EAST TOWER

SUITE 300 | 5,040 RSF

SAWTELLE/WEST LA

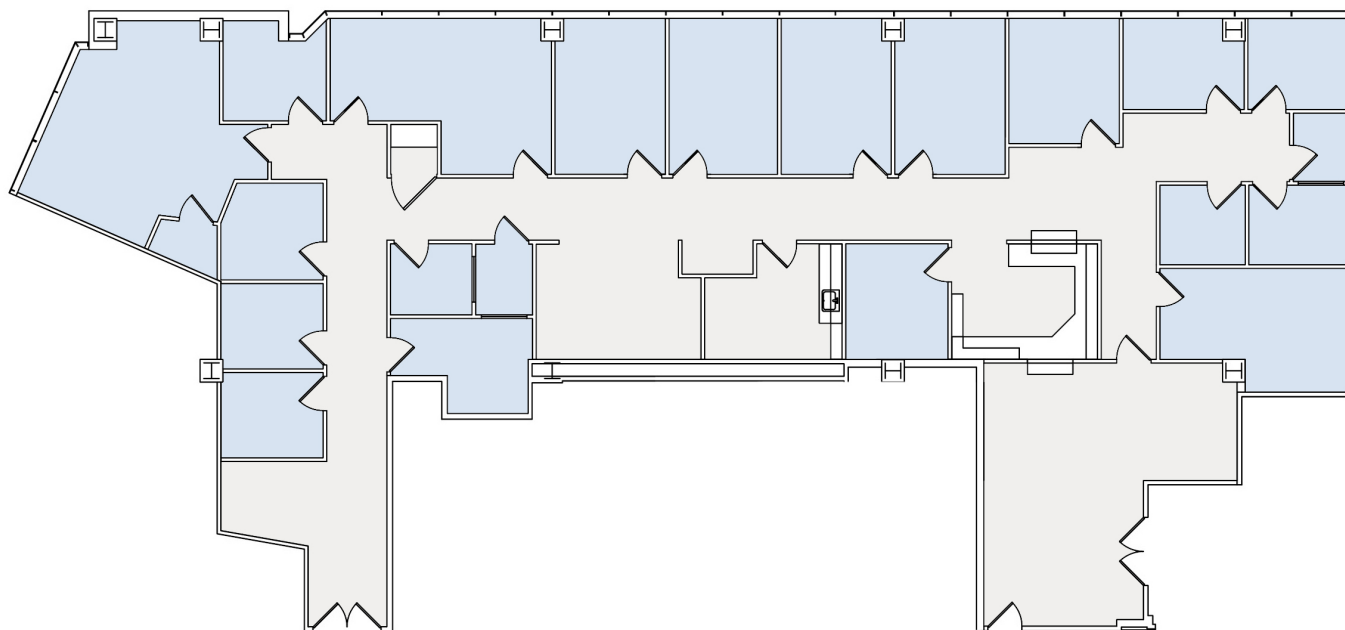

AS-BUILT CONFIGURATION

OFFICES:	21
CONFERENCE ROOM:	1
RECEPTION:	1
KITCHEN:	1
PANTRY:	1

NOT TO SCALE
FURNITURE NOT INCLUDED

For more information, please contact:

310.255.7777
leasing@douglasemmett.com

**Douglas
Emmett**