


# 11150 W OLYMPIC

OLYMPIC CENTER

SUITE 780 | 1,916 RSF

SAWTELLE/WEST LA

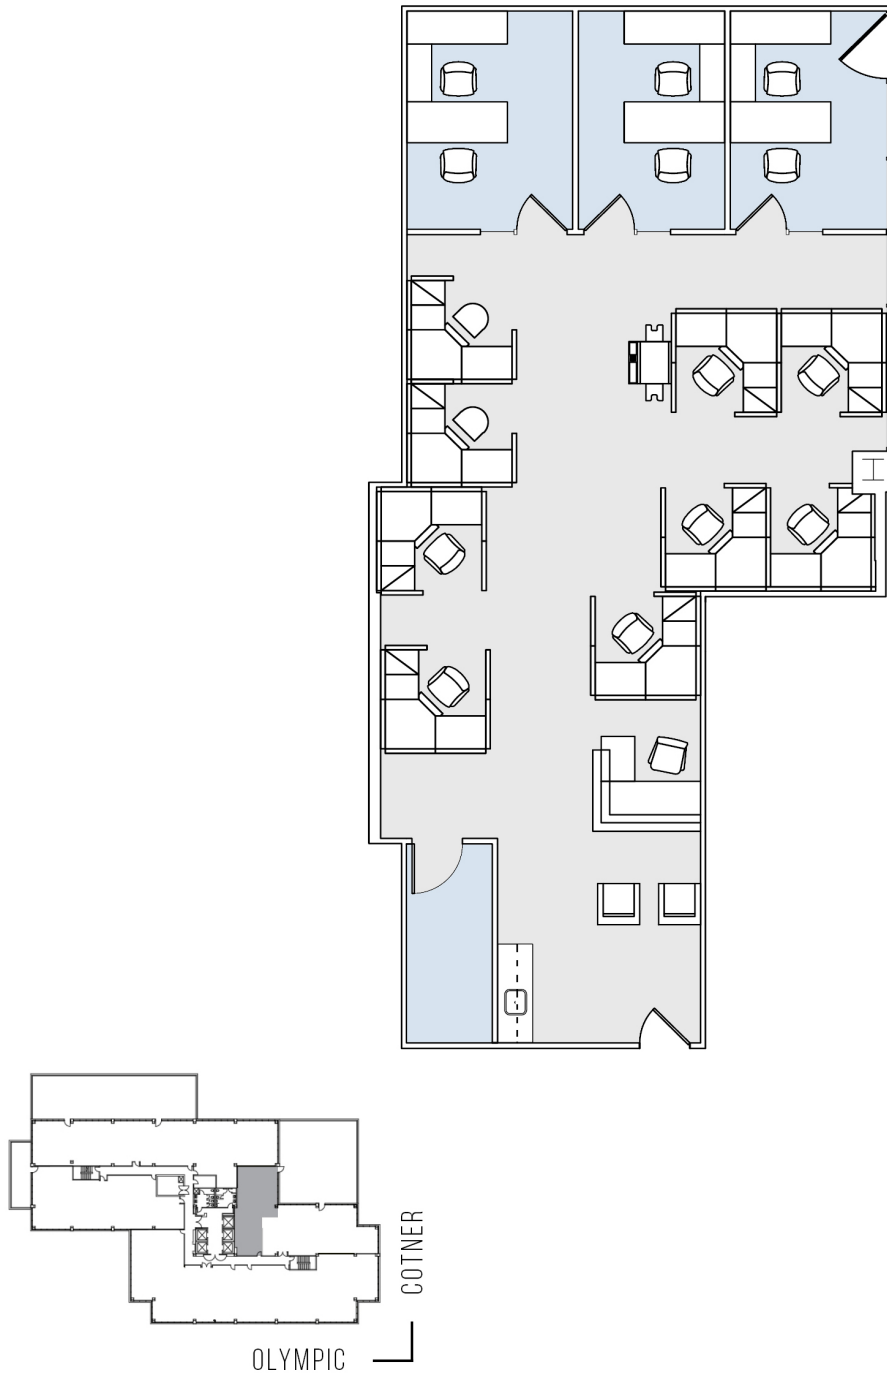

#### AS-BUILT CONFIGURATION

OFFICES:	3
RECEPTION:	1
KITCHEN:	1
SERVER ROOM:	1

ADJUSTED FOR SOCIAL DISTANCING  
NOT TO SCALE  
FURNITURE NOT INCLUDED

For more information, please contact:

310.255.7777  
leasing@douglasemmett.com

**Douglas  
Emmett**