
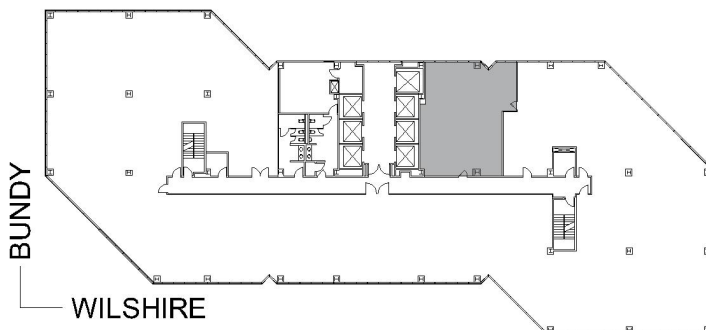


12100 WILSHIRE

SUITE 280 | 1,557 RSF

BRENTWOOD-WILSHIRE

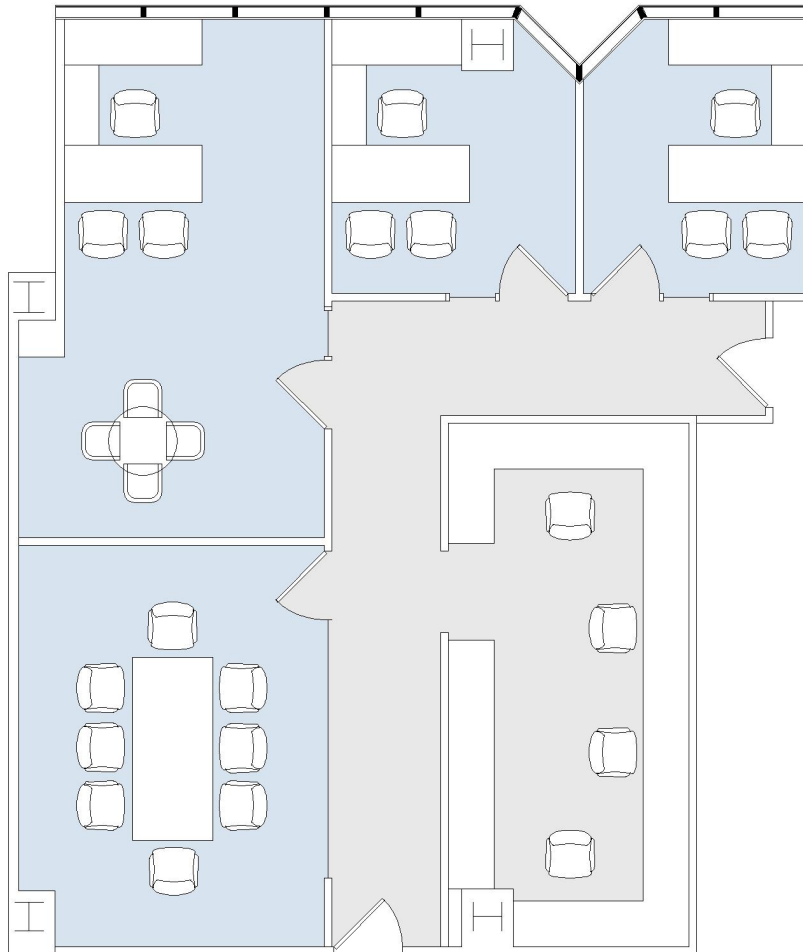

AS-BUILT CONFIGURATION

OFFICES: 3

CONFERENCE ROOM: 1

NOT TO SCALE

FURNITURE NOT INCLUDED

For more information, please contact:

310.255.7777
leasing@douglasemmett.com

**Douglas
Emmett**