



BEVERLY HILLS

## SAN VICENTE

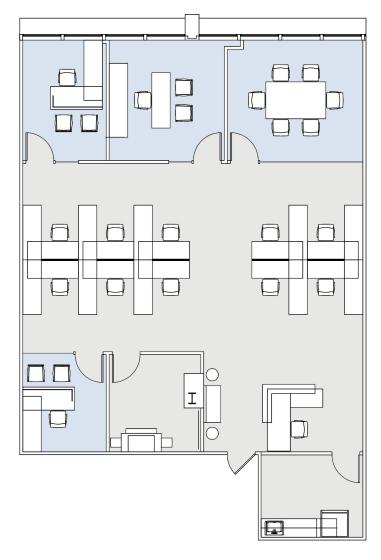

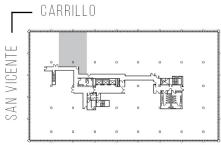

AS-BUILT CONFIGURATION	
OFFICE:	3
CONFERENCE ROOM:	1
RECEPTION:	1
KITCHEN:	1
COPY ROOM:	1
NOT TO SCALE	

NOT TO SCALE FURNITURE NOT INCLUDED

For more information, please contact:

