


1901


SUITE 680 | 6,273 RSF

CENTURY CITY

AVENUE OF THE STARS

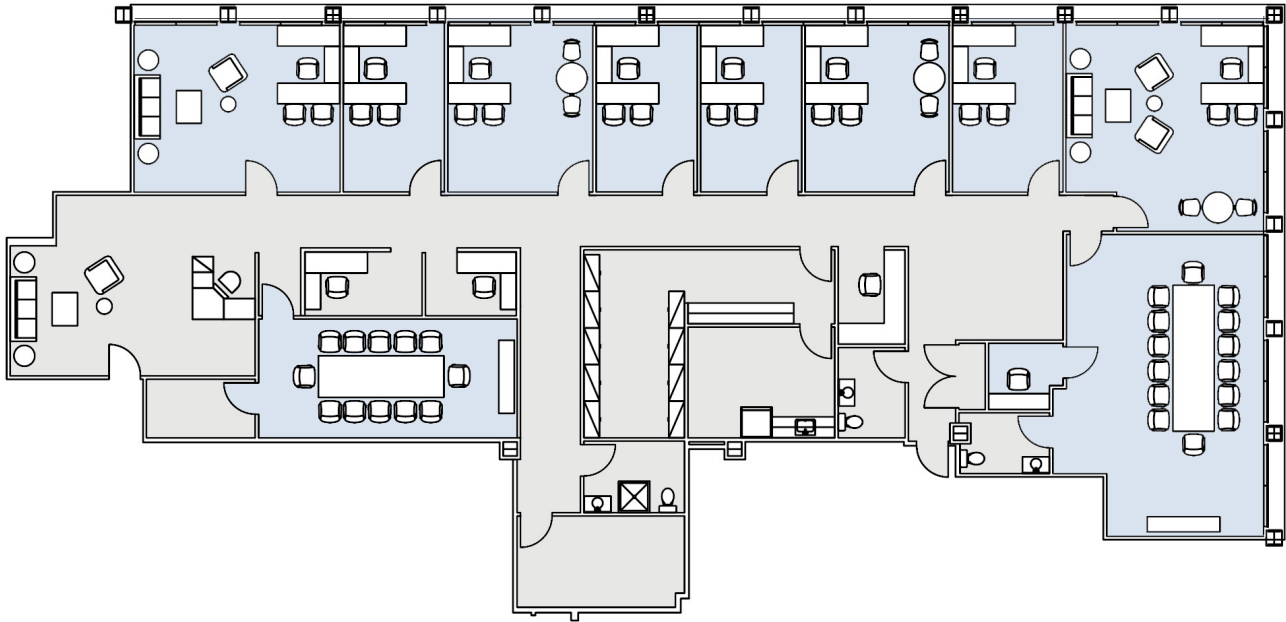

AVENUE OF THE STARS

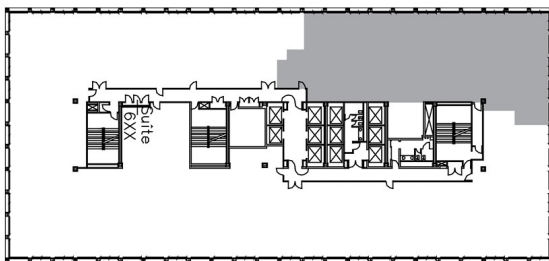

SANTA MONICA

AS-BUILT CONFIGURATION

OFFICES:	8
RECEPTION:	1
CONFERENCE ROOM:	2
KITCHEN:	1
STORAGE ROOMS:	4
RESTEROOMS:	3
PHONE ROOM:	1

NOT TO SCALE
FURNITURE NOT INCLUDED

For more information, please contact:

310.255.7777
leasing@douglasemmett.com**Douglas
Emmett**