
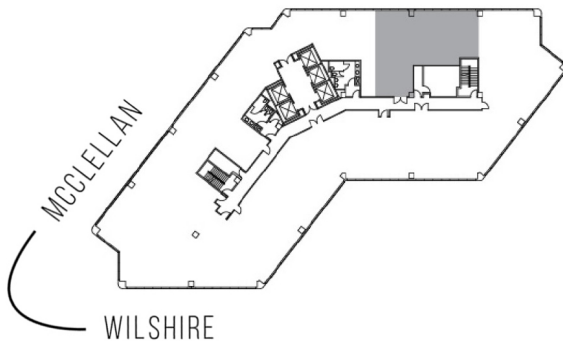


12400 WILSHIRE

SUITE 1480 | 1,889 RSF

BRENTWOOD-WILSHIRE

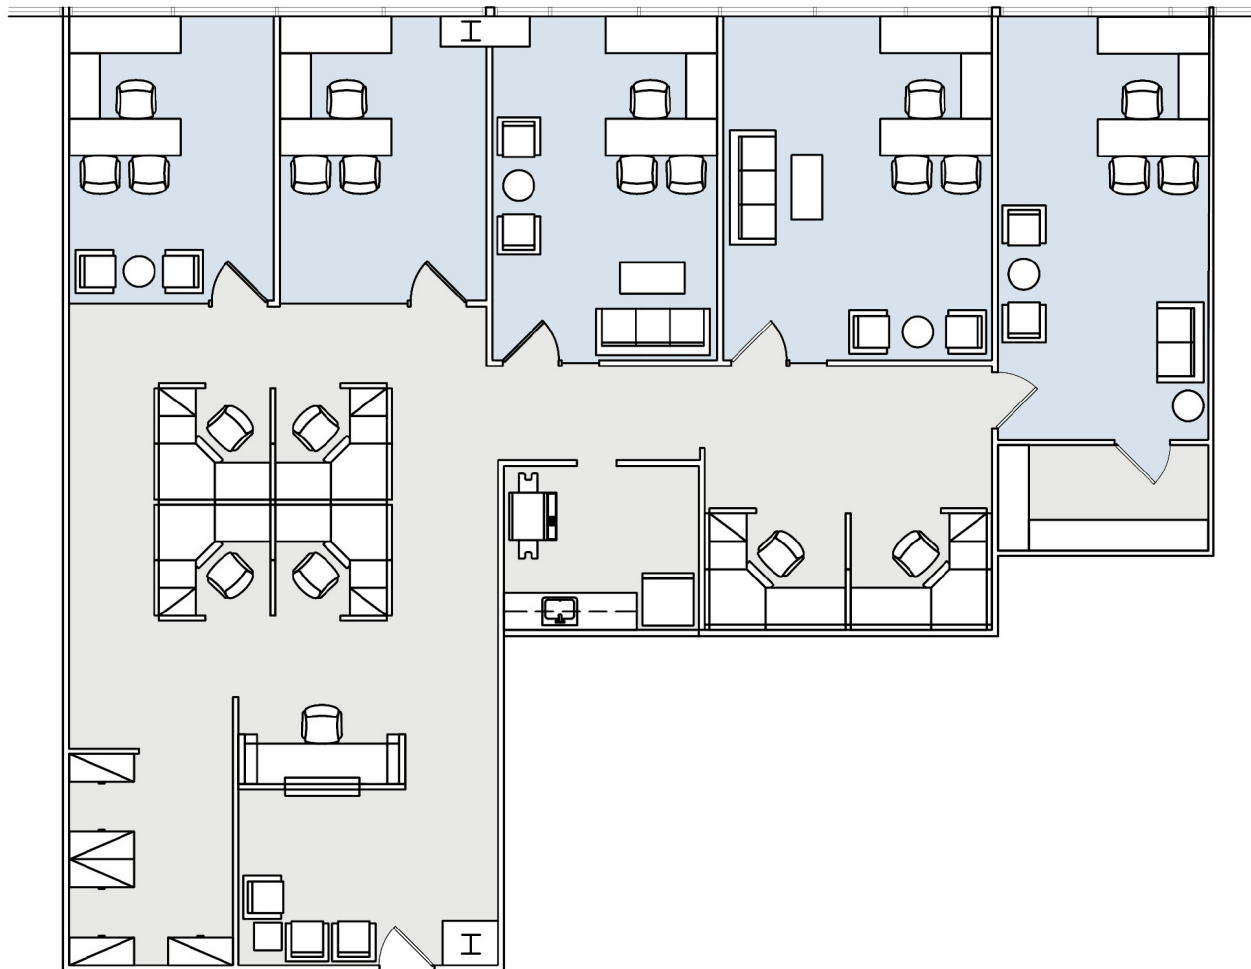

AS-BUILT CONFIGURATION

OFFICE:	5
RECEPTION:	1
KITCHEN:	1
STORAGE:	1

NOT TO SCALE
FURNITURE NOT INCLUDED

For more information, please contact:

310.255.7777
leasing@douglasemmett.com

**Douglas
Emmett**