


15260 VENTURA

VALLEY EXECUTIVE TOWER

SUITE 1220 | 3,254 RSF

SHERMAN OAKS/ENCINO

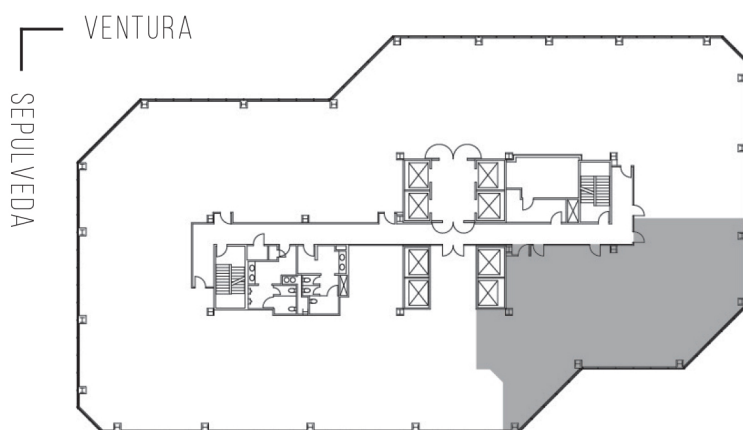

AS-BUILT CONFIGURATION

OFFICES:	7
WORKSTATIONS:	5
CONFERENCE:	1
RECEPTION:	1
KITCHEN:	1

NOT TO SCALE
FURNITURE NOT INCLUDED

For more information, please contact:

310.255.7777
leasing@douglasemmett.com

**Douglas
Emmett**