

15301

SHERMAN OAKS/ENCINO

VENTURA

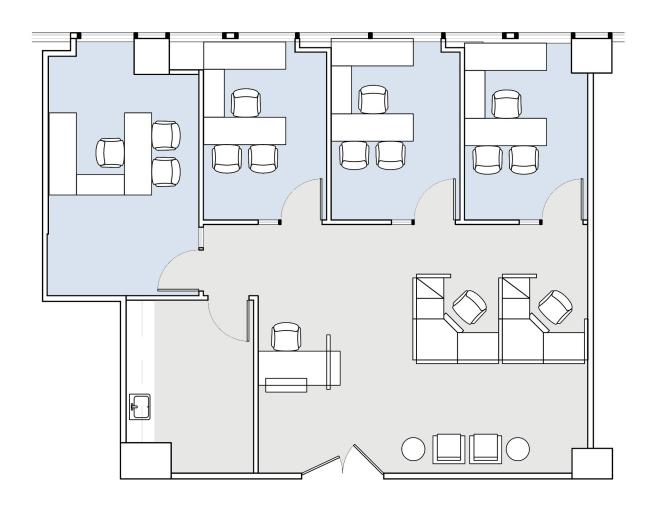

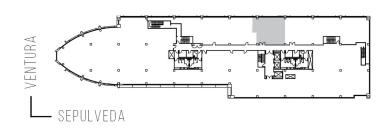

AS-BUILT CONFIGURATION	
OFFICES:	4
RECEPTION:	1
KITCHEN:	1
NOT TO SCALE FURNITURE NOT INCLUDED	

For more information, please contact:

