
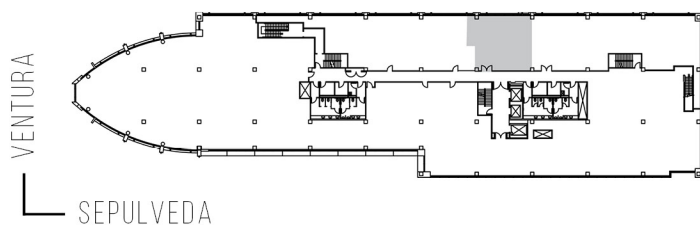


15301
VENTURA

SOG-GARDEN OFFICE BUILDING

SUITE 350 | 1,506 RSF

SHERMAN OAKS/ENCINO

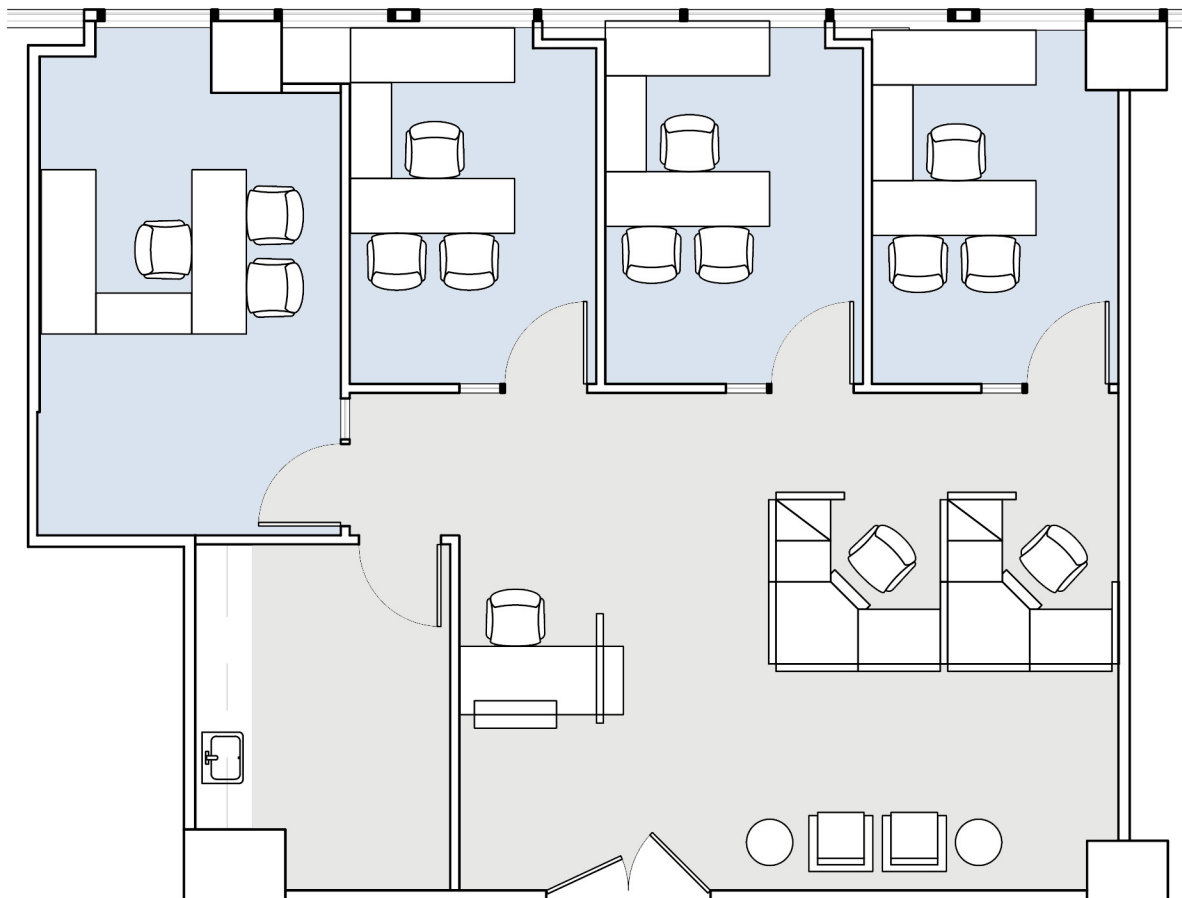

AS-BUILT CONFIGURATION

| | |
|------------|---|
| OFFICES: | 4 |
| RECEPTION: | 1 |
| KITCHEN: | 1 |

NOT TO SCALE
FURNITURE NOT INCLUDED

For more information, please contact:

310.255.7777
leasing@douglasemmett.com

**Douglas
Emmett**