



11999

BRENTWOOD/SALTAIR

SUITE 325 | 1,330 RSF

BRENTWOOD-SAN VICENTE

# SAN VICENTE

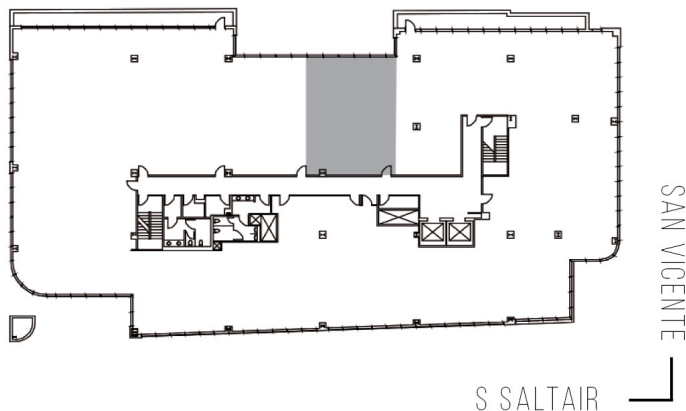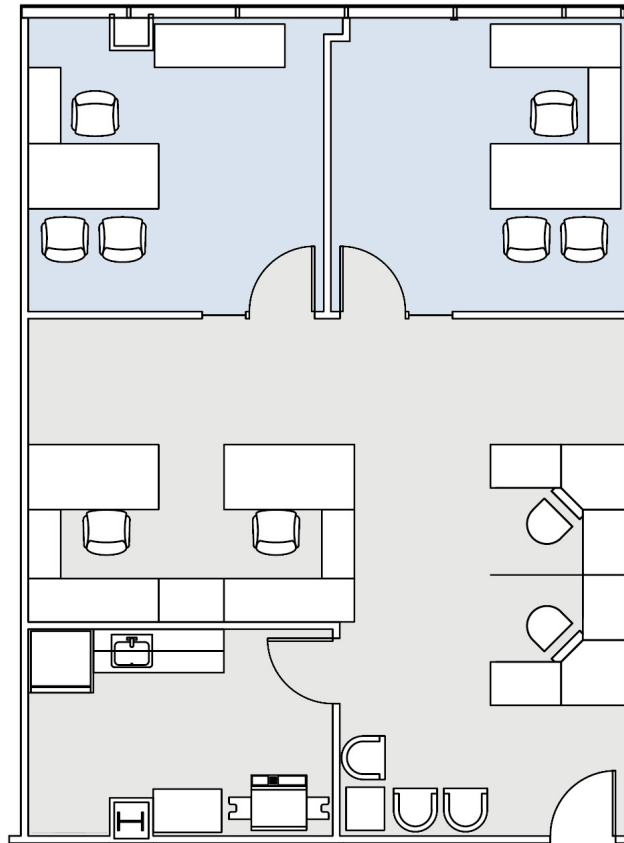

## AS-BUILT CONFIGURATION

OFFICES:	2
KITCHEN/STORAGE:	1
RECEPTION AREA:	1

NOT TO SCALE  
FURNITURE NOT INCLUDED

For more information, please contact:

310.255.7777  
leasing@douglasemmett.com

**Douglas  
Emmett**