

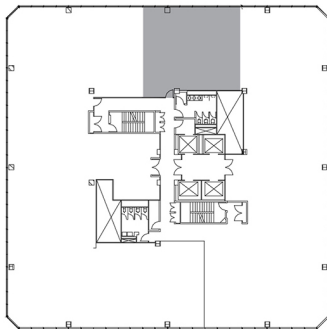
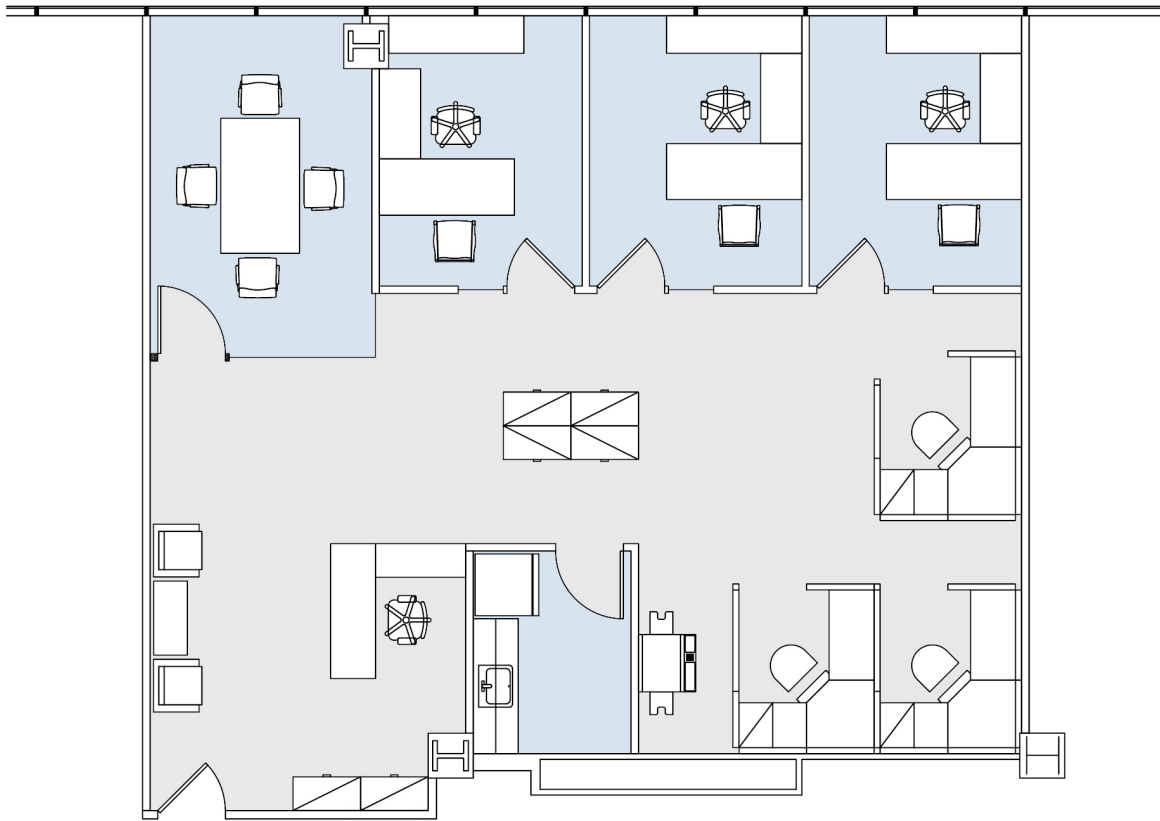
1801

CENTURY PARK PLAZA

SUITE 2050 | 1,600 RSF

CENTURY CITY

## CENTURY PARK EAST

CENTURY PARK EAST  
SANTA MONICA BLVD

## AS-BUILT CONFIGURATION

OFFICES:	3
CONFERENCE ROOM:	1
RECEPTION:	1
KITCHEN:	1

ADJUSTED FOR SOCIAL DISTANCING  
NOT TO SCALE  
FURNITURE NOT INCLUDED

For more information, please contact:

310.255.7777  
leasing@douglasemmett.com**Douglas  
Emmett**