
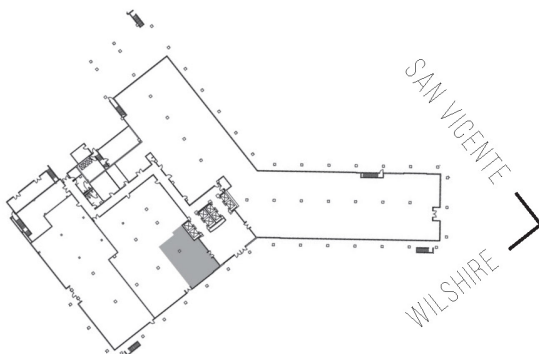


8383  
WILSHIRE

SUITE 660 | 1,691 RSF

BEVERLY HILLS

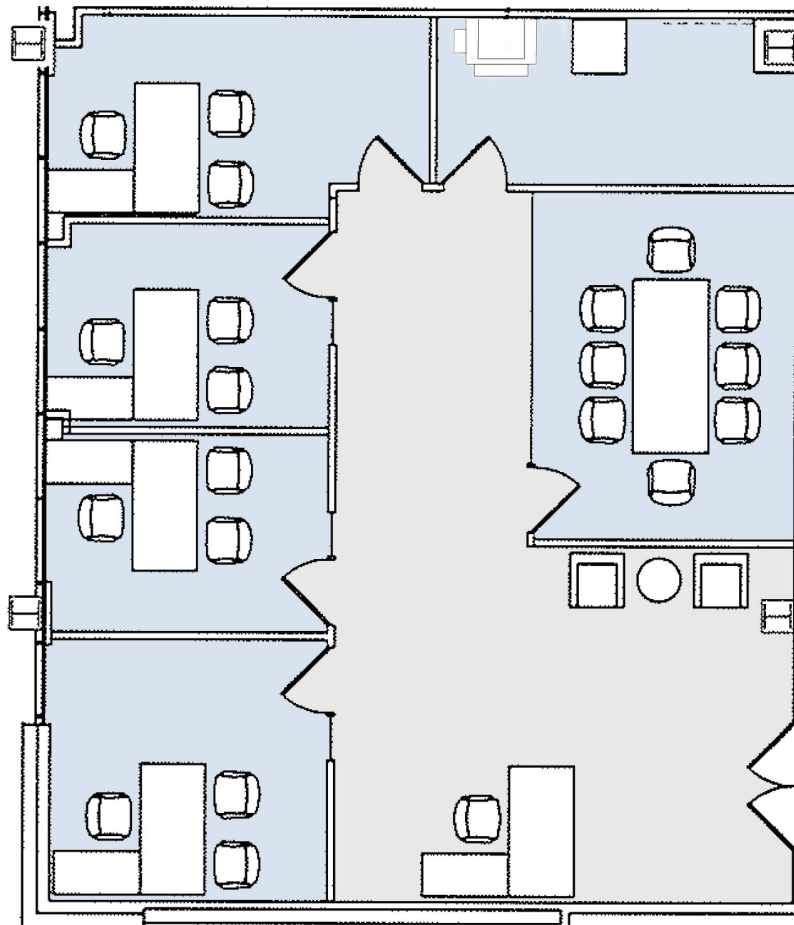

AS-BUILT CONFIGURATION

OFFICES:	4
CONFERENCE ROOM:	1
RECEPTION AREA:	1
FILE/COPY ROOM:	1

NOT TO SCALE  
FURNITURE NOT INCLUDED

For more information, please contact:

310.255.7777  
leasing@douglasemmett.com

**Douglas  
Emmett**