
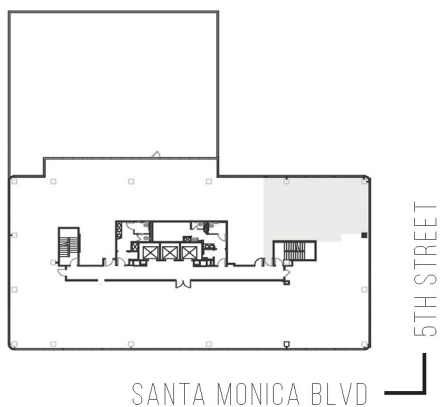


429

SUITE 300 | 1,587 RSF

SANTA MONICA

SANTA MONICA

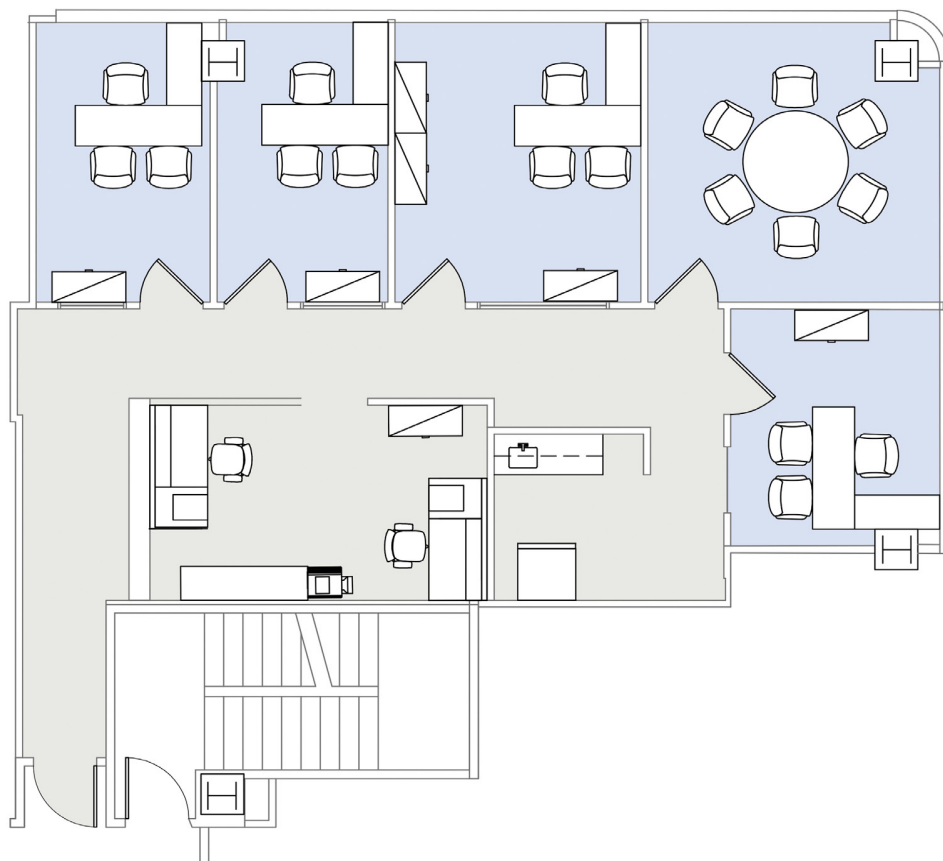

AS-BUILT CONFIGURATION

OFFICES:	4
WORKSTATIONS:	2
CONFERENCE ROOM:	1
KITCHEN:	1

NOT TO SCALE
FURNITURE NOT INCLUDED

For more information, please contact:

310.255.7777
leasing@douglasemmett.com

**Douglas
Emmett**