
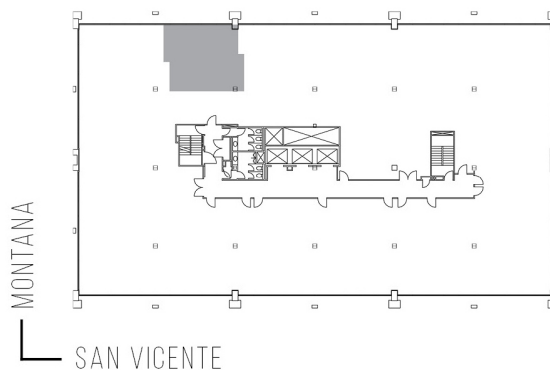


11777 SAN VICENTE

SUITE 670 | 664 RSF
BRENTWOOD-SAN VICENTE

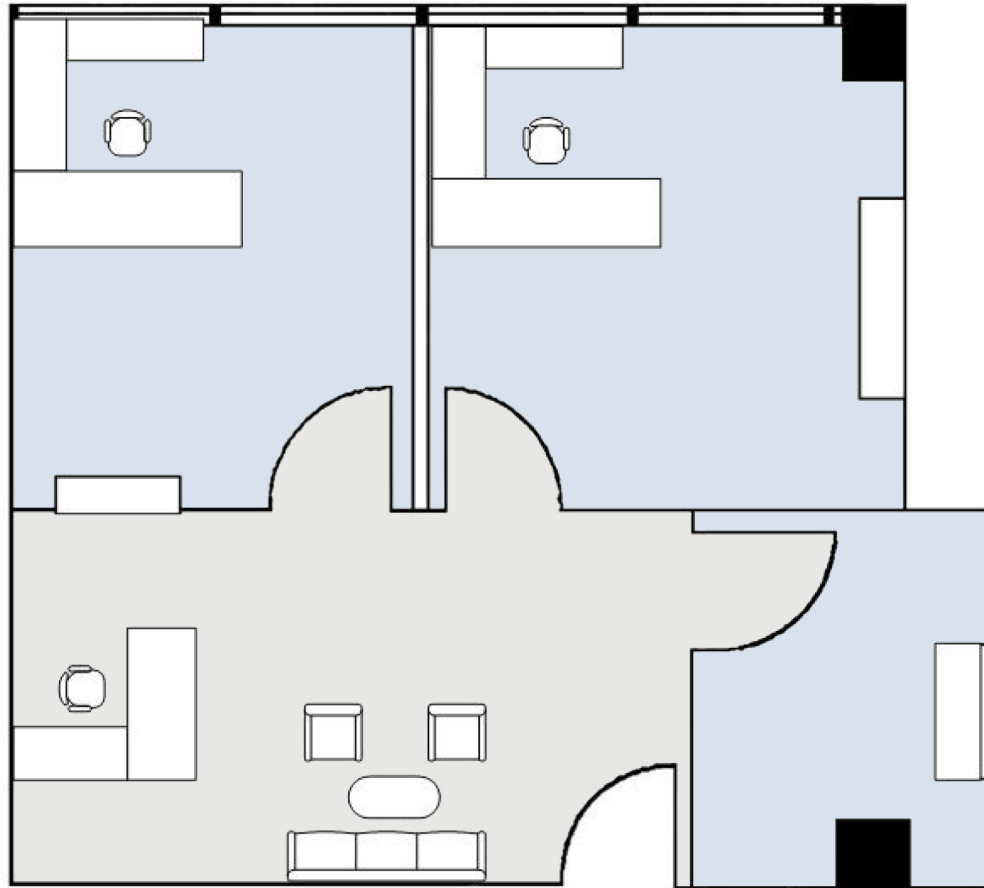

AS-BUILT CONFIGURATION

OFFICES:	2
RECEPTION:	1
KITCHEN:	1

NOT TO SCALE
FURNITURE NOT INCLUDED

For more information, please contact:

310.255.7777
leasing@douglasemmett.com

**Douglas
Emmett**