


1801

CENTURY PARK PLAZA

SUITE 1520 | 3,037 RSF

CENTURY CITY

CENTURY PARK EAST

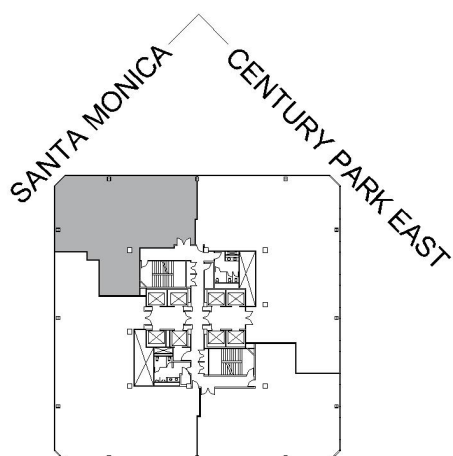

AS-BUILT CONFIGURATION

OFFICES:	4
CONFERENCE ROOM:	1
RECEPTION:	1
KITCHEN:	1
STORAGE ROOM:	1
CLOSET:	2

NOT TO SCALE

FURNITURE NOT INCLUDED

For more information, please contact:

310.255.7777
leasing@douglasemmett.com

**Douglas
Emmett**