
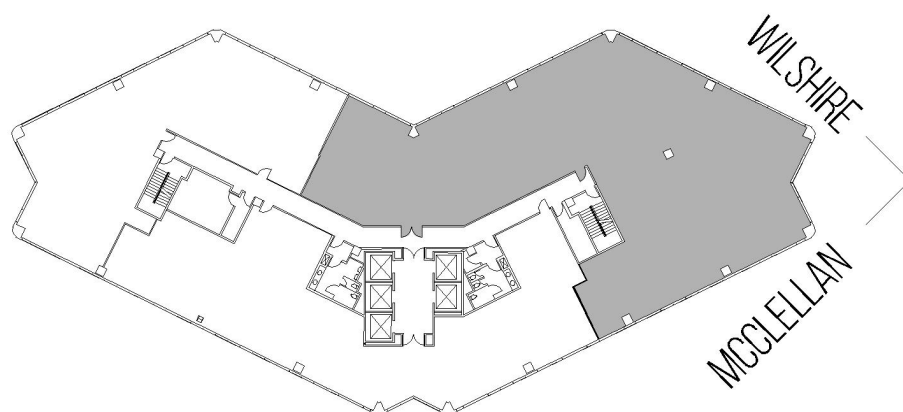


12400 WILSHIRE

SUITE 400 | 8,169 RSF

BRENTWOOD-WILSHIRE

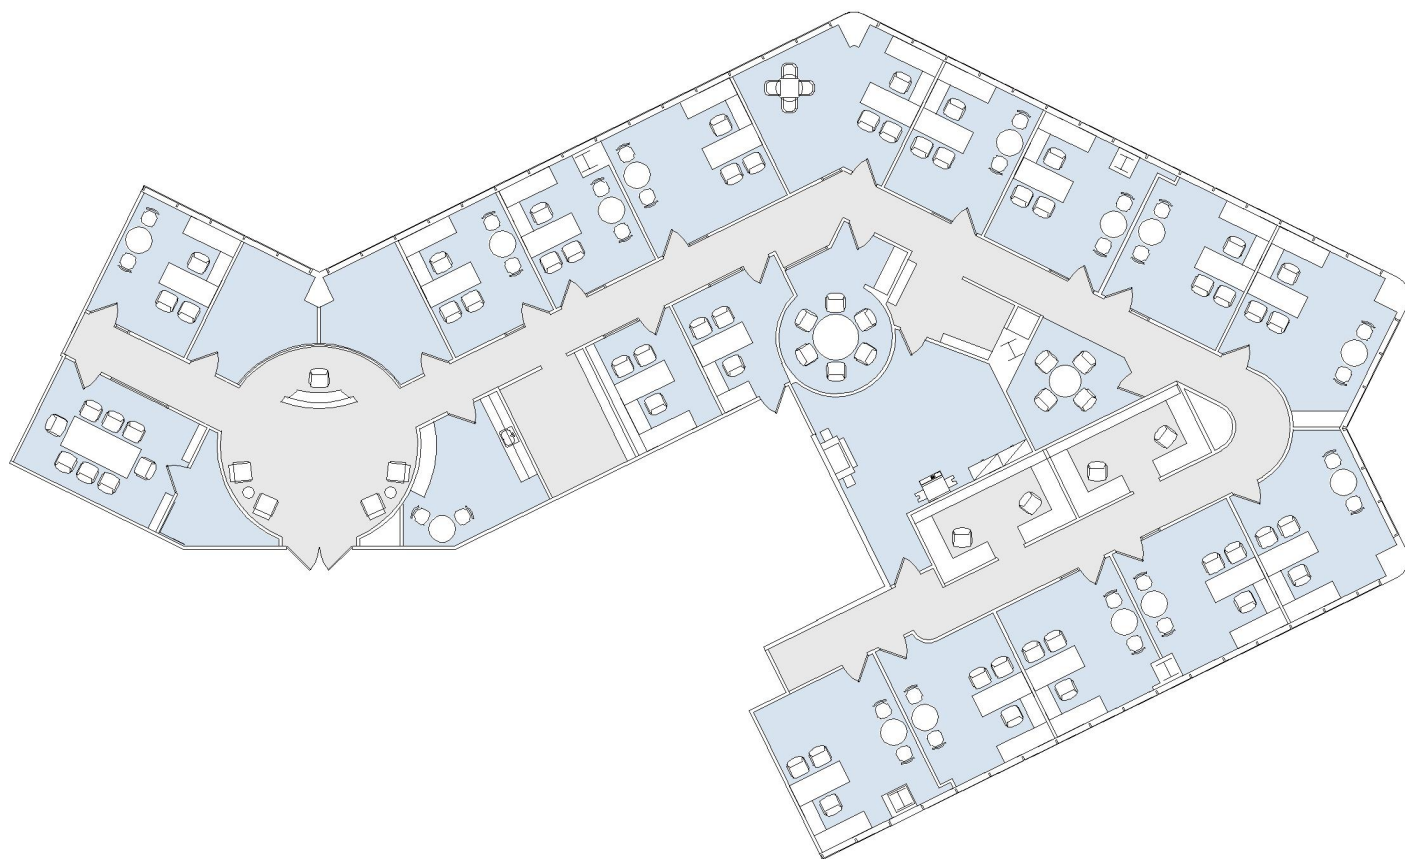

AS-BUILT CONFIGURATION

OFFICES:	16
CONFERENCE ROOM:	3
RECEPTION:	1
KITCHEN:	1
COPY ROOM:	1
IT ROOM:	1
STORAGE ROOM:	2

NOT TO SCALE
FURNITURE NOT INCLUDED

For more information, please contact:

310.255.7777
leasing@douglasemmett.com

**Douglas
Emmett**