
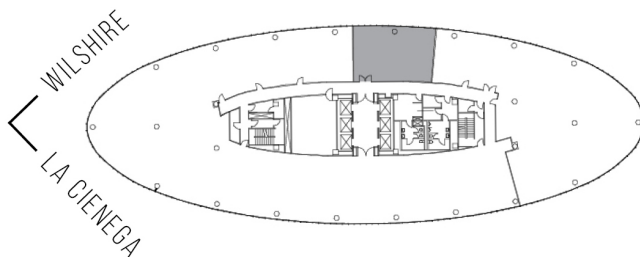


8484 WILSHIRE

SUITE 450 | 1,394 RSF

BEVERLY HILLS

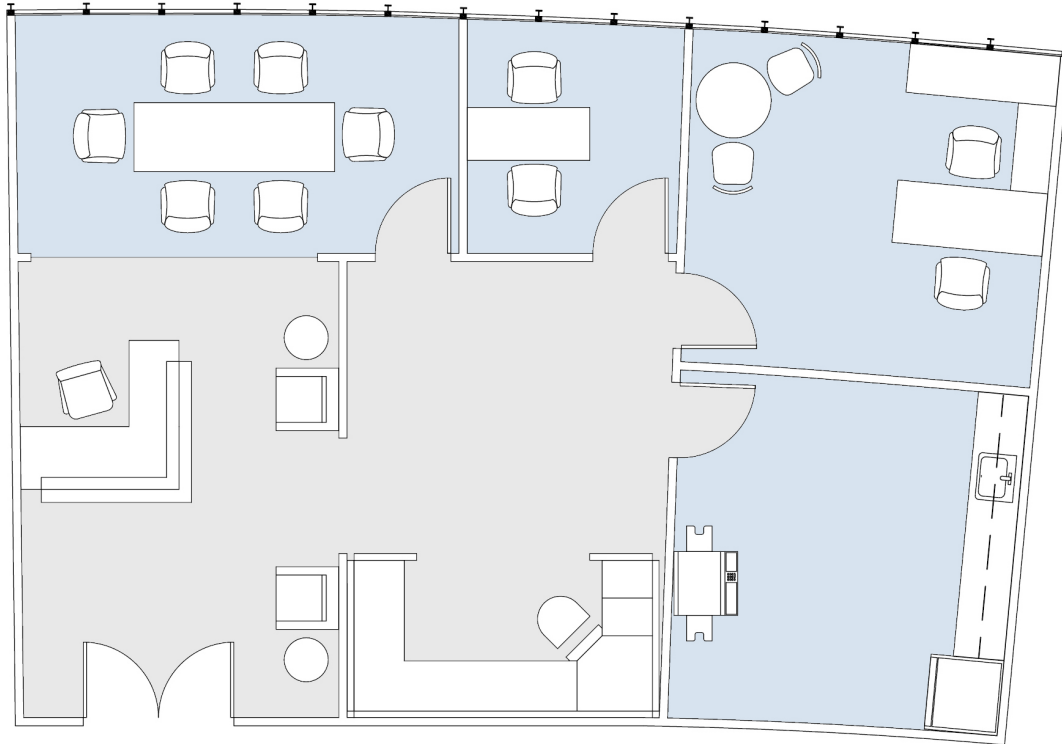

AS-BUILT CONFIGURATION

OPEN OFFICE:	2
CONFERENCE ROOM:	1
RECEPTION:	1
KITCHEN:	1

ADJUSTED FOR SOCIAL DISTANCING
NOT TO SCALE
FURNITURE NOT INCLUDED

For more information, please contact:

310.255.7777
leasing@douglasemmett.com

**Douglas
Emmett**