

BEVERLY HILLS

WILSHIRE

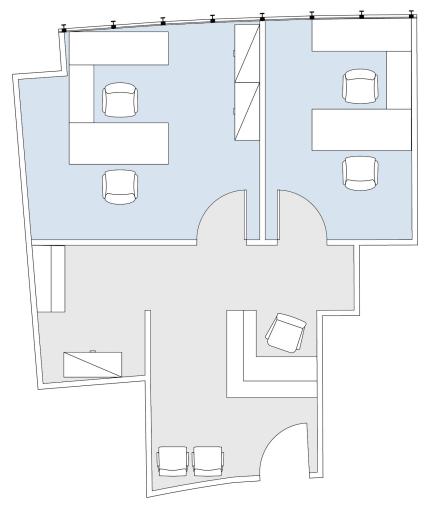

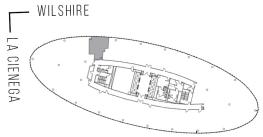

AS-BUILT CONFIGURATION	
OFFICES:	2
RECEPTION:	1
ADJUSTED FOR SOCIAL DISTANCING NOT TO SCALE FURNITURE NOT INCLUDED	

For more information, please contact:

