
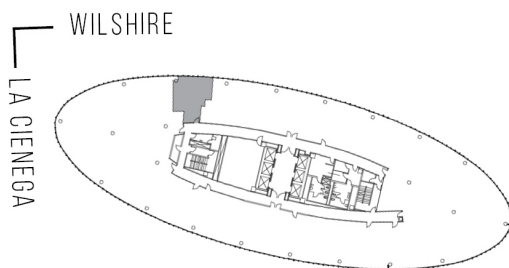


8484 WILSHIRE

SUITE 502 | 635 RSF

BEVERLY HILLS

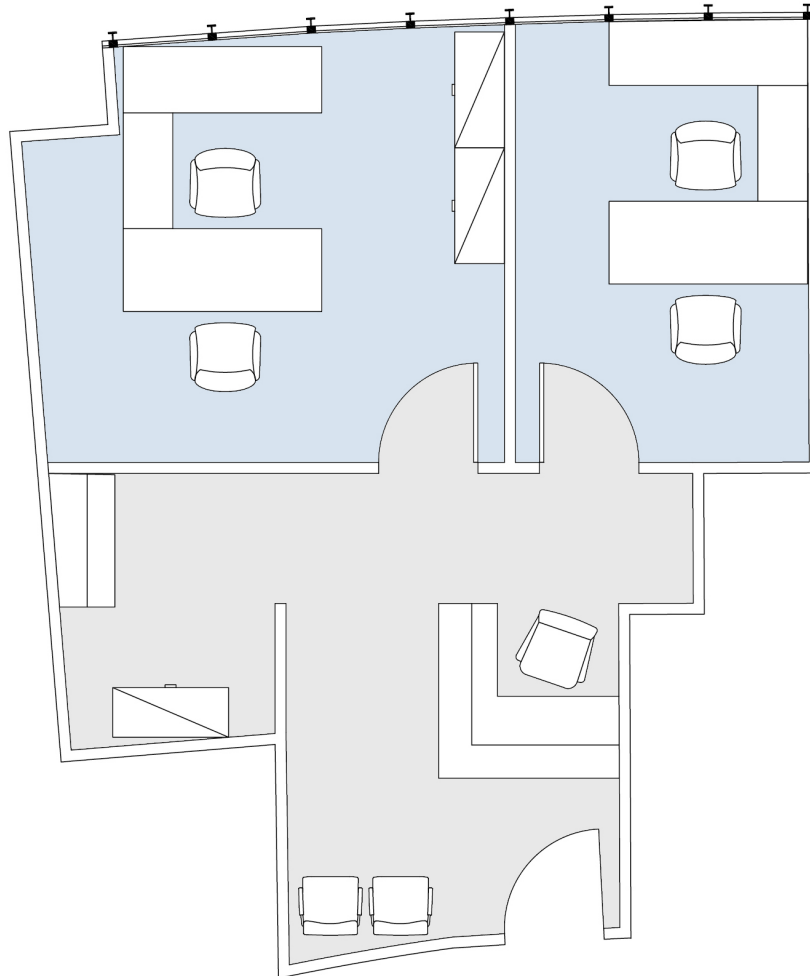

AS-BUILT CONFIGURATION

OFFICES:	2
RECEPTION:	1

ADJUSTED FOR SOCIAL DISTANCING
NOT TO SCALE
FURNITURE NOT INCLUDED

For more information, please contact:

310.255.7777
leasing@douglasemmett.com

**Douglas
Emmett**