
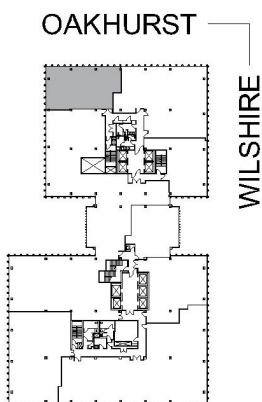


9100 WILSHIRE

9100 WILSHIRE WEST TOWER

SUITE W0720 | 2,183 RSF

BEVERLY HILLS

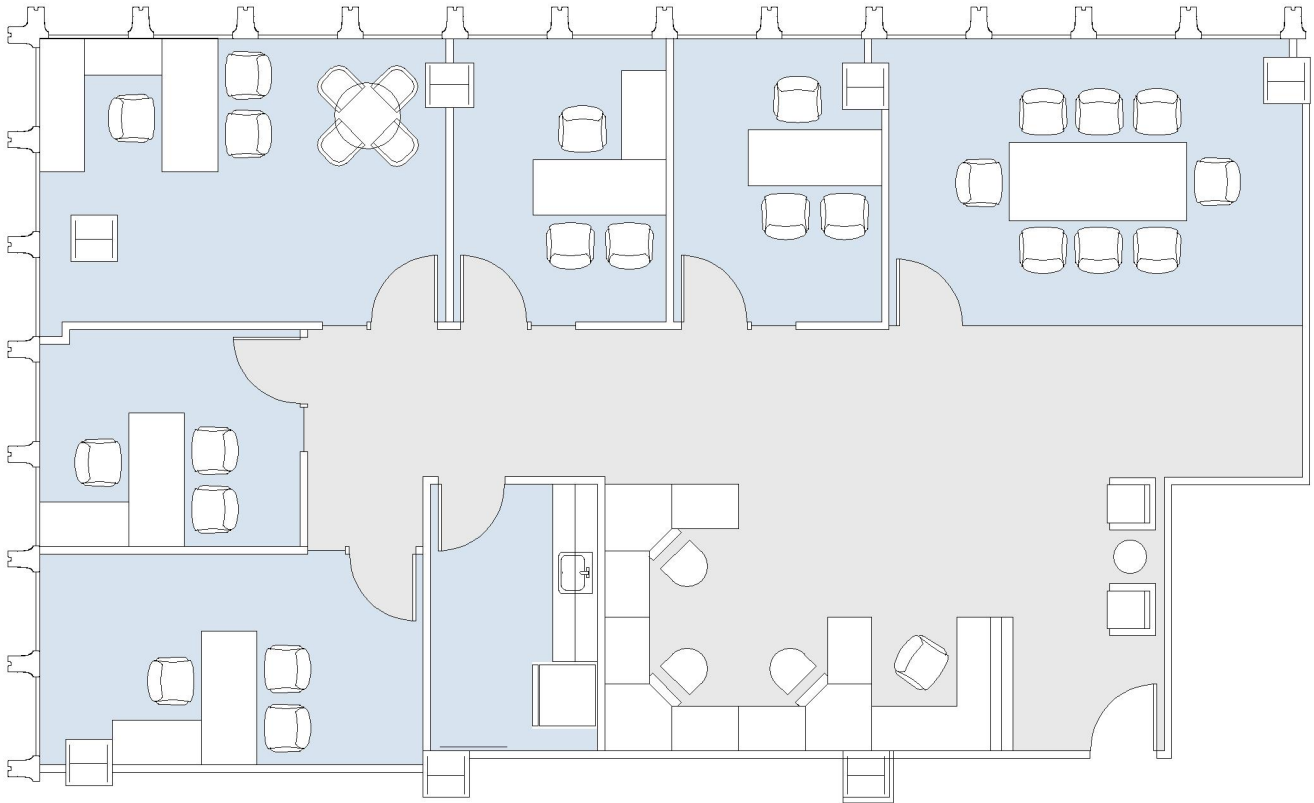

AS-BUILT CONFIGURATION

OFFICES:	5
CONFERENCE ROOM:	1
RECEPTION:	1
KITCHEN:	1

NOT TO SCALE

FURNITURE NOT INCLUDED

For more information, please contact:

310.255.7777
leasing@douglasemmett.com

**Douglas
Emmett**