
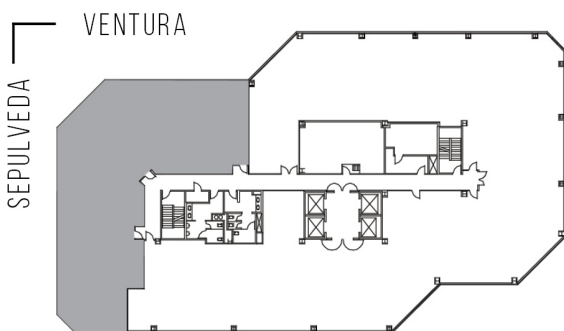


# 15260 VENTURA

VALLEY EXECUTIVE TOWER

SUITE 1410 | 4,937 RSF

SHERMAN OAKS/ENCINO

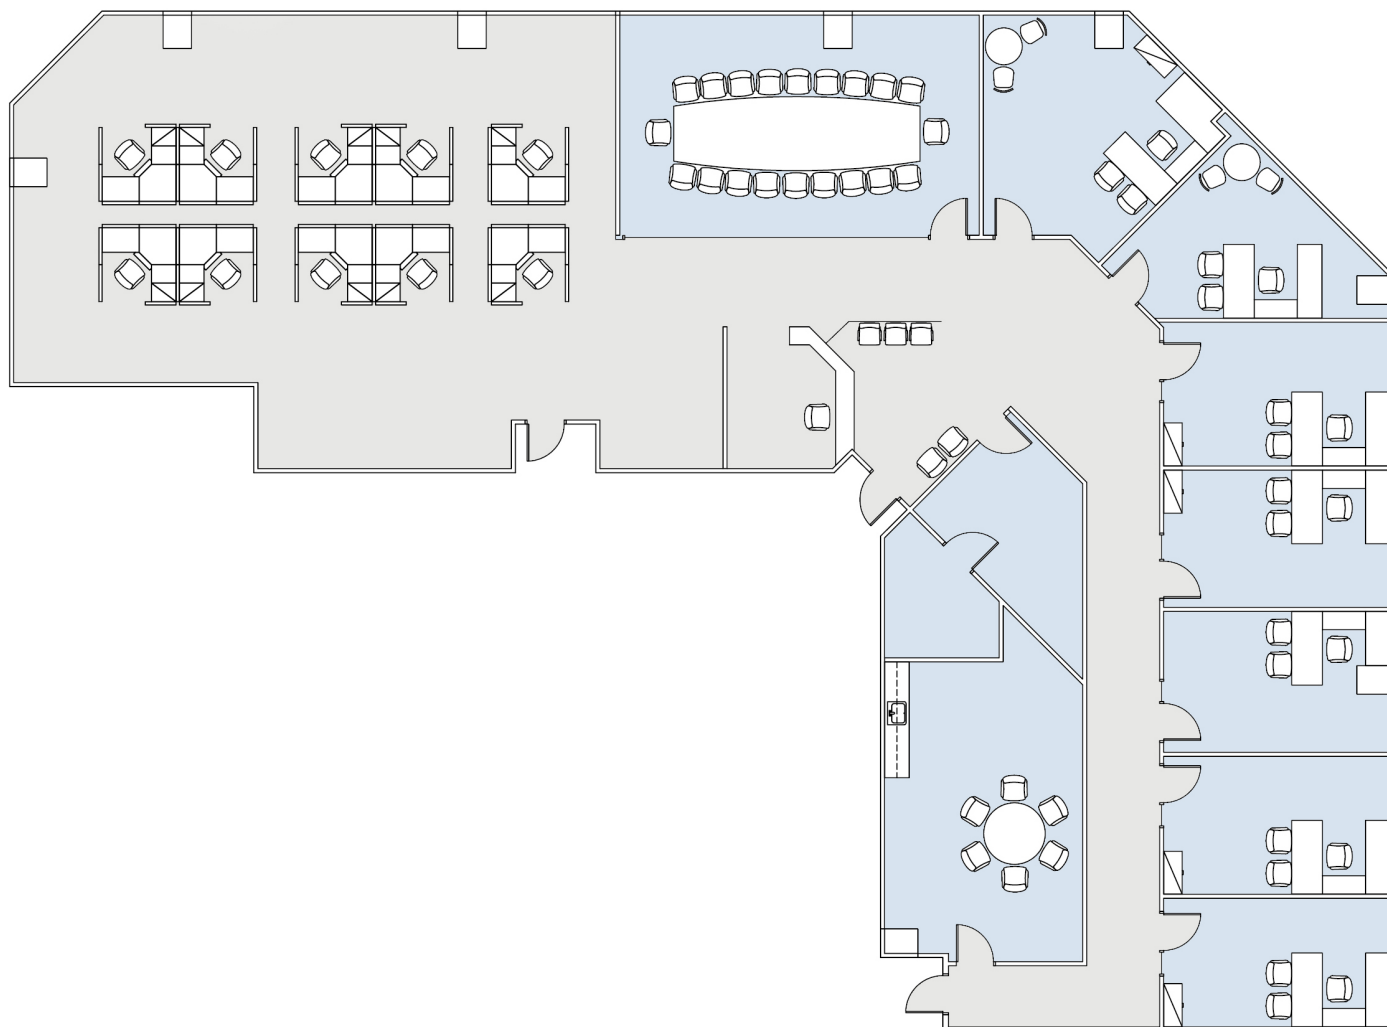

## AS-BUILT CONFIGURATION

|                  |   |
|------------------|---|
| OFFICES:         | 7 |
| CONFERENCE ROOM: | 1 |
| RECEPTION AREA:  | 1 |
| BREAK ROOM:      | 1 |
| IT ROOM:         | 2 |

NOT TO SCALE  
FURNITURE NOT INCLUDED

For more information, please contact:

310.255.7777  
leasing@douglasemmett.com

**Douglas  
Emmett**