

SANTA MONICA

## **WILSHIRE**

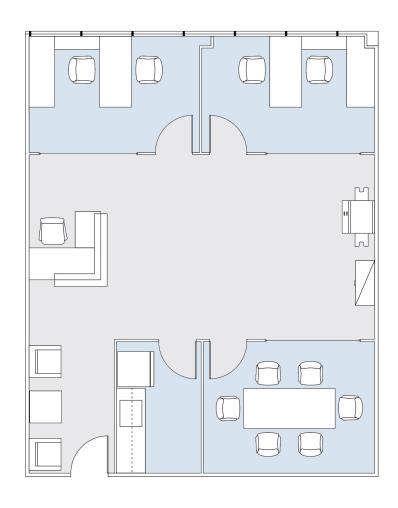

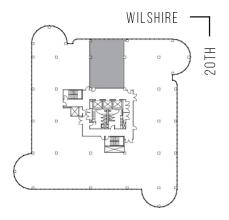

AS-BUILT CONFIGURATION	
OFFICES:	2
CONFERENCE ROOM:	1
RECEPTION:	1
KITCHEN:	1
ADJUSTED FOR SOCIAL DISTANCING NOT TO SCALE FURNITURE NOT INCLUDED	

## For more information, please contact:

