


12121 WILSHIRE

WILSHIRE BUNDY PLAZA

SUITE 305 | 6,004 RSF

BRENTWOOD-WILSHIRE

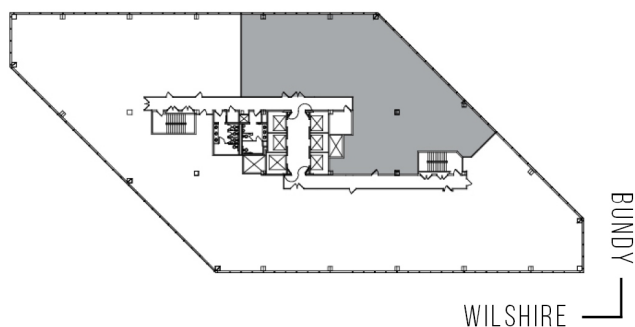

AS-BUILT CONFIGURATION

OFFICES:	6
CONFERENCE ROOM:	1
RECEPTION AREA:	1
KITCHENS:	2
I.T. ROOM:	1
OPEN OFFICE:	2

ADJUSTED FOR SOCIAL DISTANCING
NOT TO SCALE
FURNITURE NOT INCLUDED

For more information, please contact:

310.255.7777
leasing@douglasemmett.com

**Douglas
Emmett**