
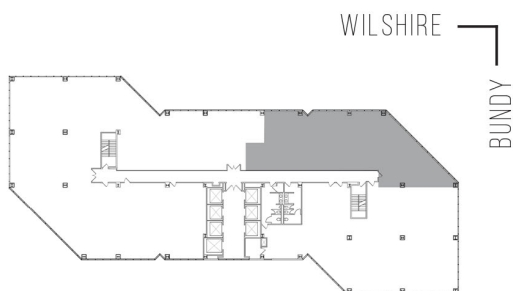


12100 WILSHIRE

SUITE 220 | 3,793 RSF

BRENTWOOD-WILSHIRE

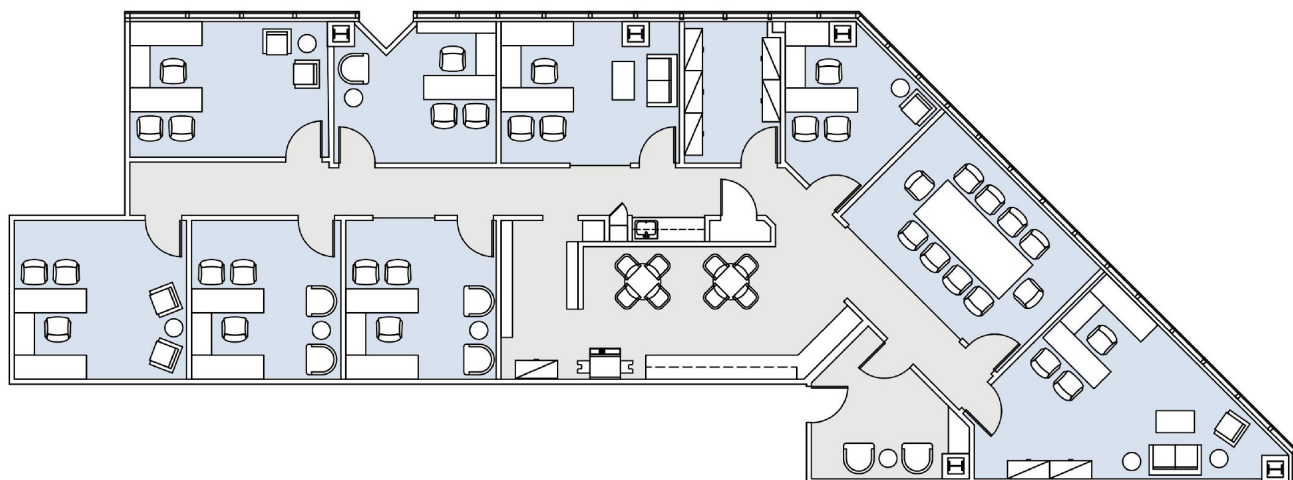

AS-BUILT CONFIGURATION

OFFICES:	8
CONFERENCE ROOM:	1
KITCHEN:	1
BREAK ROOM:	1

NOT TO SCALE
FURNITURE NOT INCLUDED

For more information, please contact:

310.255.7777
leasing@douglasemmett.com

**Douglas
Emmett**