


12100 WILSHIRE

SUITE 1100 | 5,710 RSF

BRENTWOOD-WILSHIRE

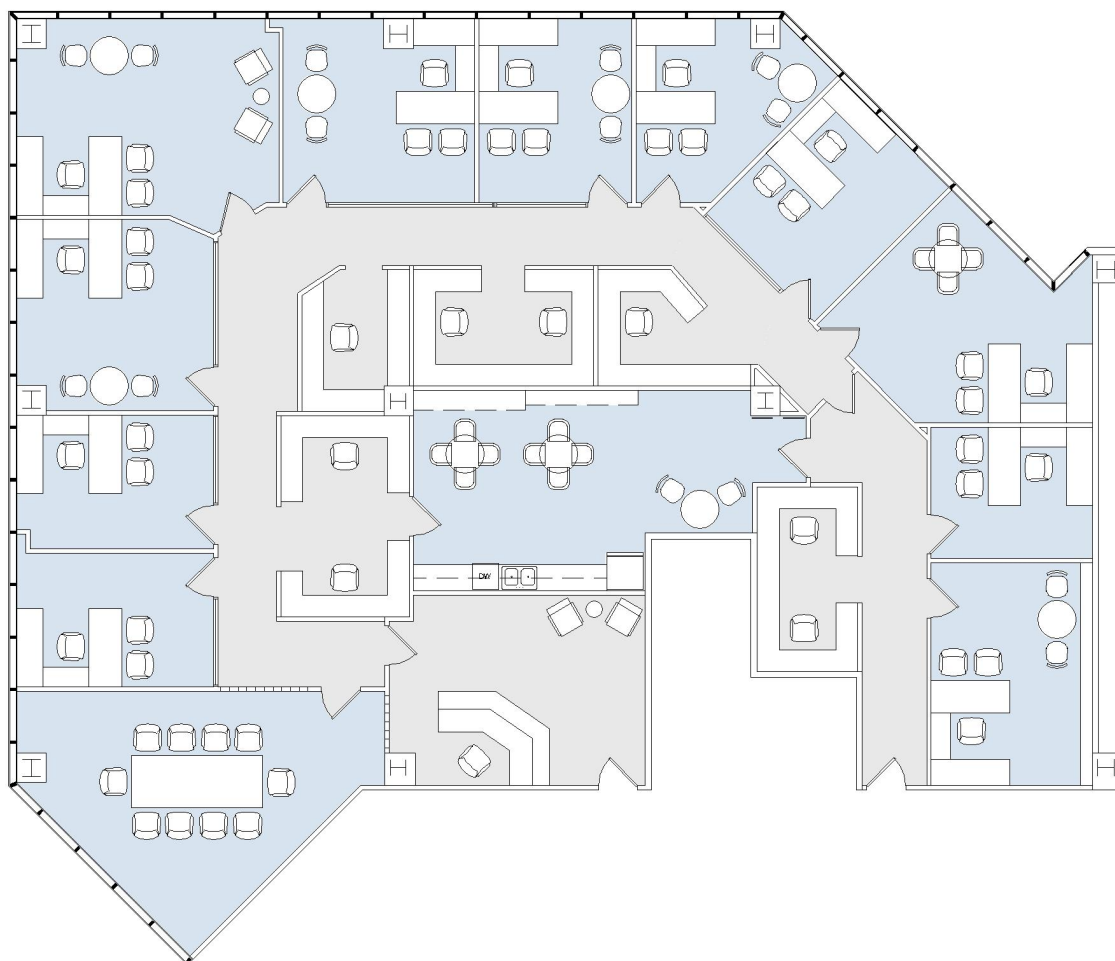


AS-BUILT CONFIGURATION

OFFICES:	11
CONFERENCE ROOM:	1
RECEPTION:	1
KITCHEN:	1

NOT TO SCALE

FURNITURE NOT INCLUDED

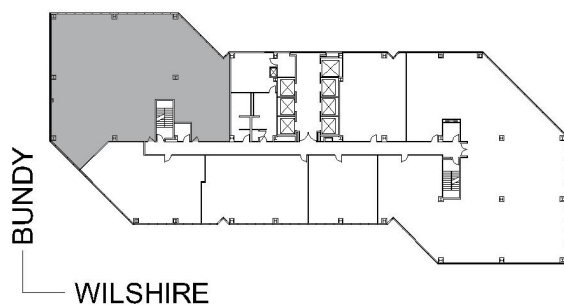

For more information, please contact:

310.255.7777
leasing@douglasemmett.com

**Douglas
Emmett**