

BRENTWOOD-WILSHIRE

WILSHIRE

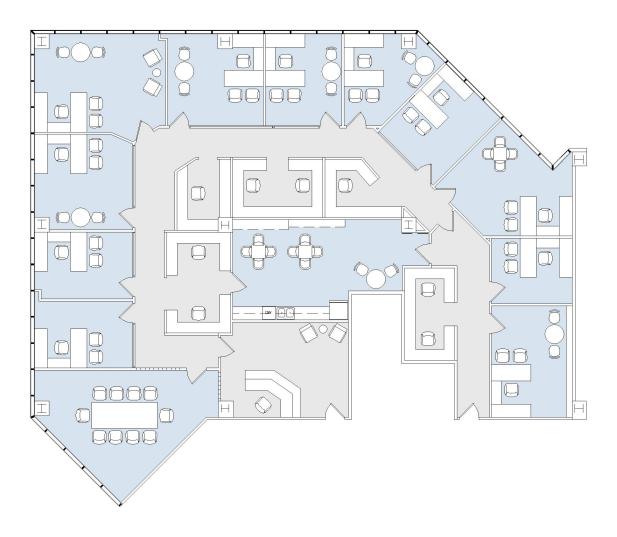

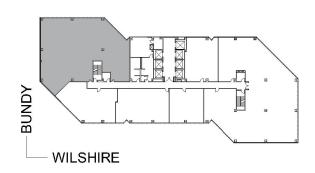

AS-BUILT CONFIGURATION

OFFICES:		11
CONFERE	ENCE ROOM:	1
RECEPTION	ON:	1
KITCHEN:		1

NOT TO SCALE
FURNITURE NOT INCLUDED

For more information, please contact:

