



21550

WARNER CENTER TOWER - II

SUITE 420 | 1,208 RSF

OXNARD STREET

WOODLAND HILLS

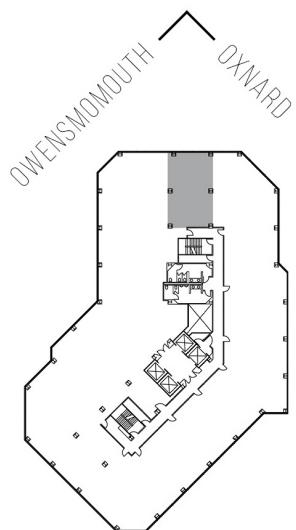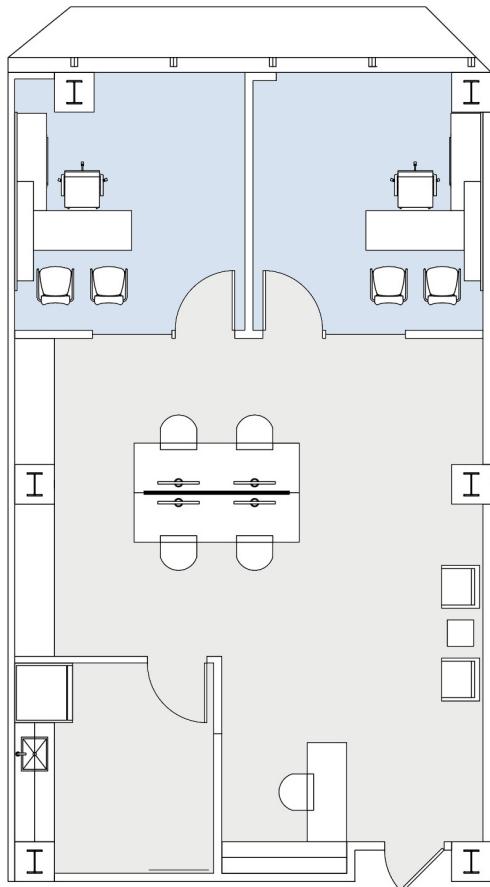

AS-BUILT CONFIGURATION

OFFICES: 2

RECEPTION: 1

KITCHEN: 1

NOT TO SCALE
FURNITURE NOT INCLUDED

For more information, please contact:

310.255.7777

leasing@douglasemmett.com

**Douglas
Emmett**