

BRENTWOOD-SAN VICENTE

SAN VICENTE

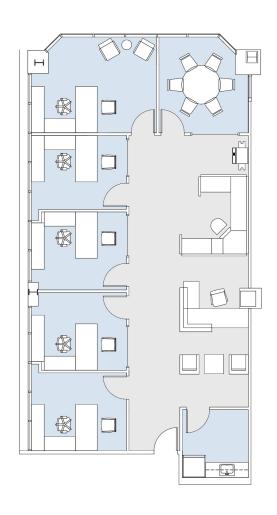

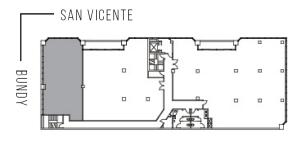

AS-BUILT CONFIGURATION	
OFFICES:	5
CONFERENCE ROOM:	1
RECEPTION:	1
KITCHEN:	1
ADJUSTED FOR SOCIAL DISTAI	NCINO

FURNITURE NOT INCLUDED

For more information, please contact:

