


11835

OLYMPIC


WESTSIDE TOWERS EAST TOWER

SUITE 1000 | 3,561 RSF

SAWTELLE/WEST LA

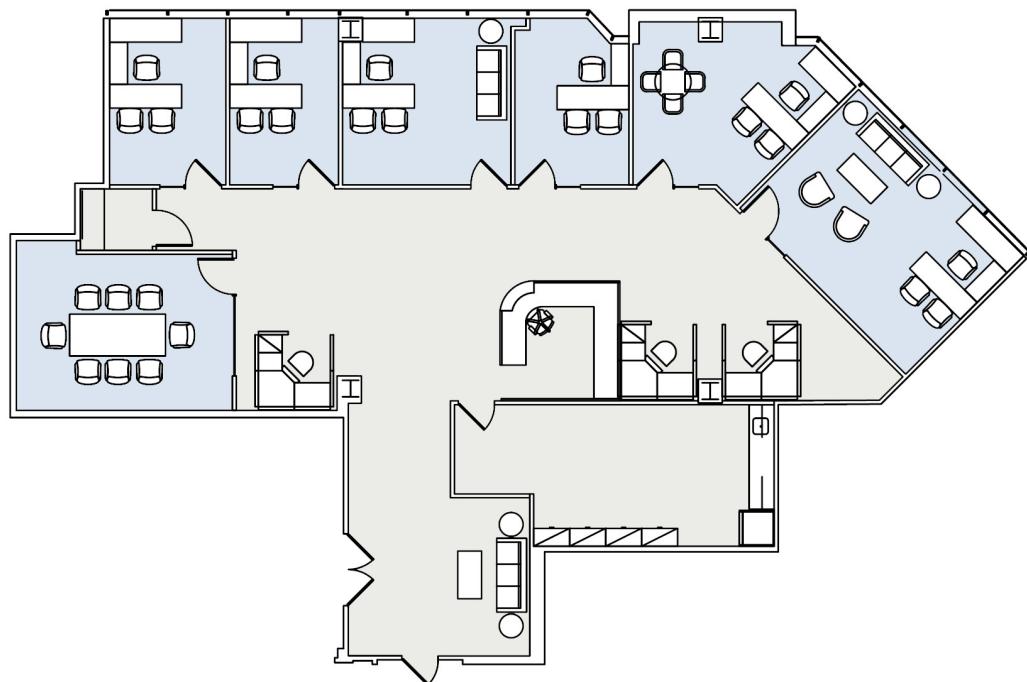

GRANVILLE

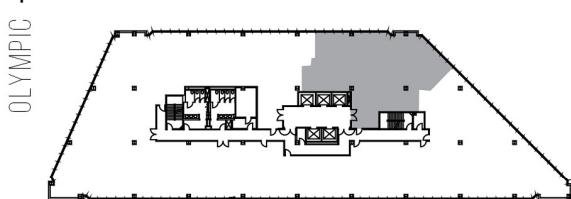

**AS-BUILT CONFIGURATION**

OFFICES:	6
CONFERENCE ROOM:	1
RECEPTION AREA:	1
KITCHEN:	1
IT/STORAGE CLOSET:	1

NOT TO SCALE  
FURNITURE NOT INCLUDED

For more information, please contact:

310.255.7777

leasing@douglasemmett.com

**Douglas  
Emmett**