



150

150 S. RODEO

SUITE 130 | 1,193 RSF

BEVERLY HILLS

S RODEO DRIVE

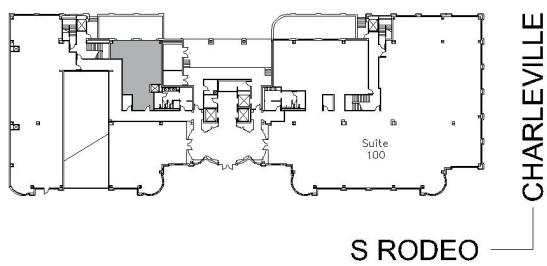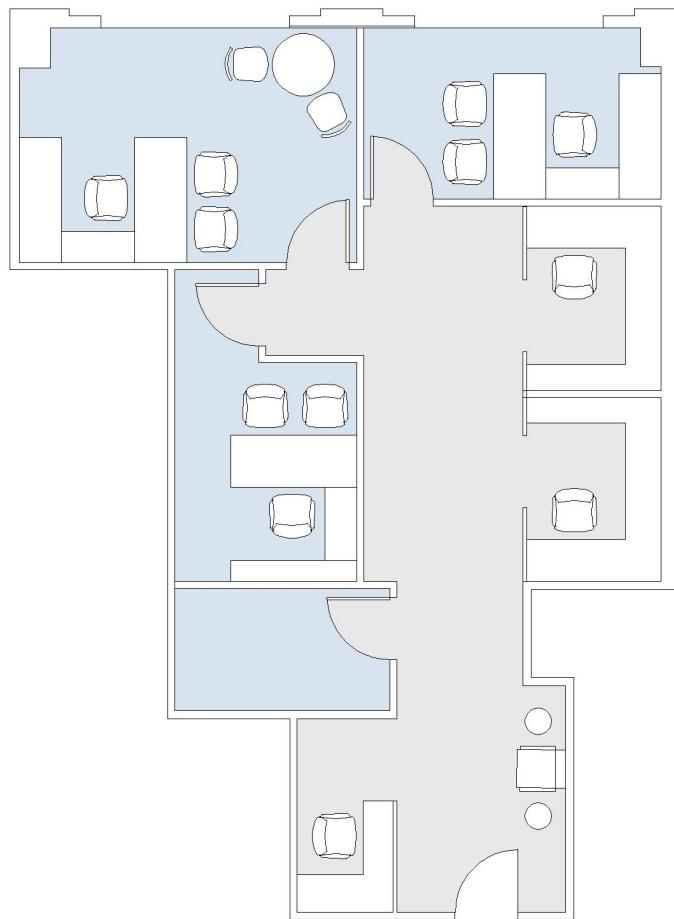

AS-BUILT CONFIGURATION

OFFICES:	3
RECEPTION:	1
STORAGE:	1

NOT TO SCALE
FURNITURE NOT INCLUDED

For more information, please contact:

310.255.7777

leasing@douglasemmett.com

**Douglas
Emmett**