
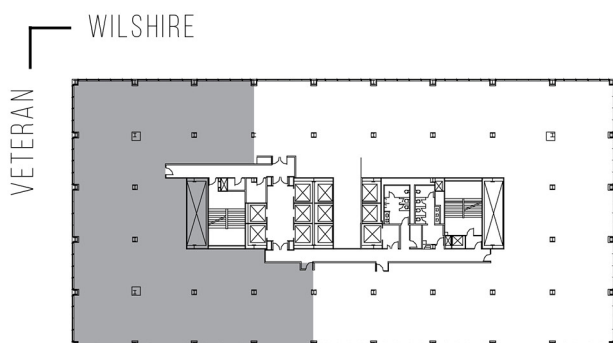


10960 WILSHIRE

SUITE 410 | 10,226 RSF

WESTWOOD

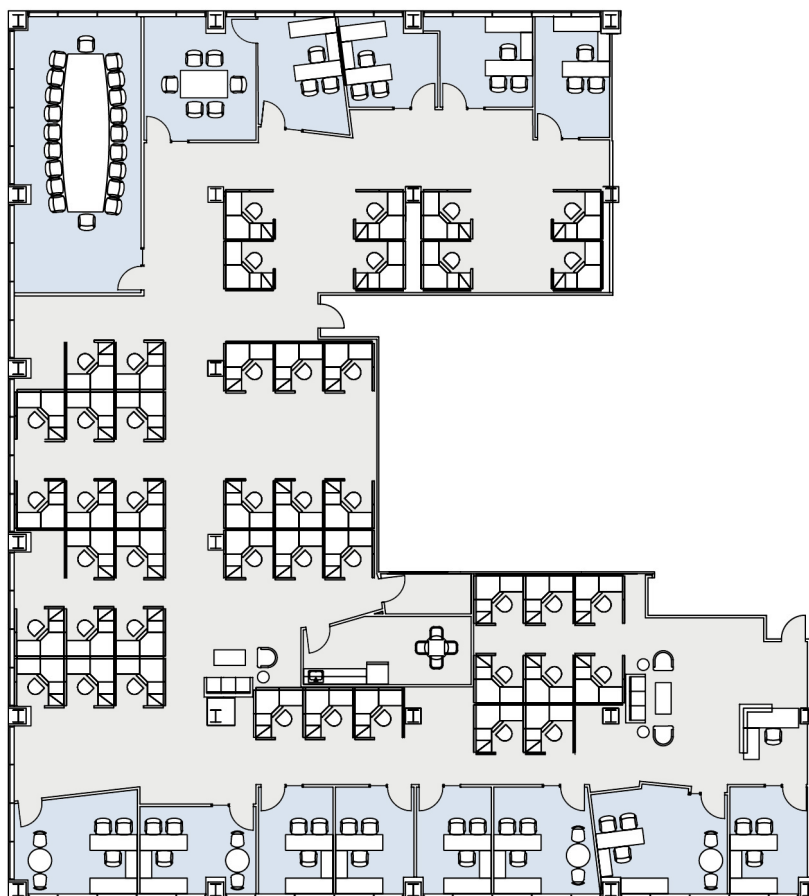

AS-BUILT CONFIGURATION

OFFICES:	12
CONFERENCE ROOMS:	2
RECEPTION:	1
STORAGE	1
KITCHEN:	1

NOT TO SCALE
FURNITURE NOT INCLUDED

For more information, please contact:

310.255.7777
leasing@douglasemmett.com

**Douglas
Emmett**