



10866

WILSHIRE

WESTWOOD PLACE

SUITE 650 | 3,672 RSF

WESTWOOD

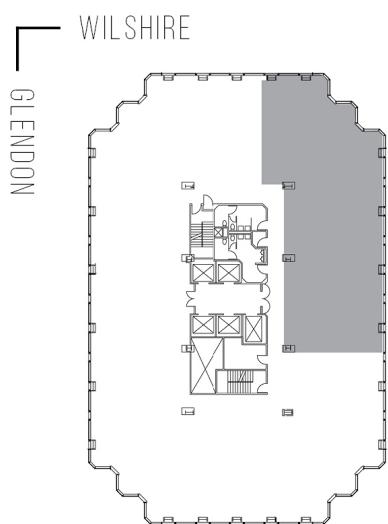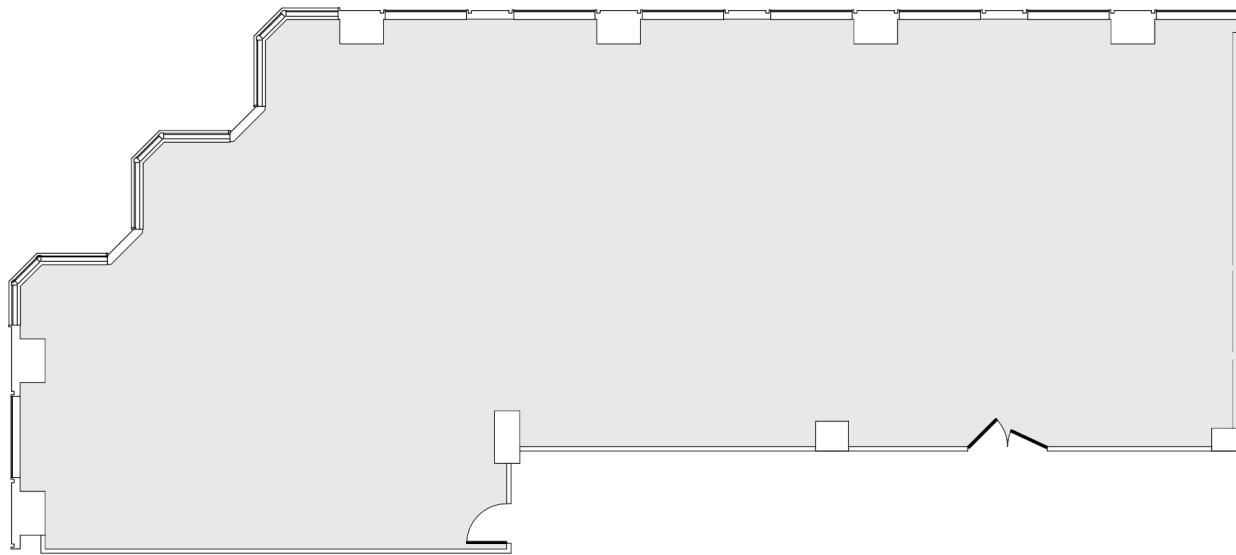

AS-BUILT CONFIGURATION

RAW SPACE

NOT TO SCALE
FURNITURE NOT INCLUDED

For more information, please contact:

310.255.7777

leasing@douglasemmett.com

**Douglas
Emmett**