
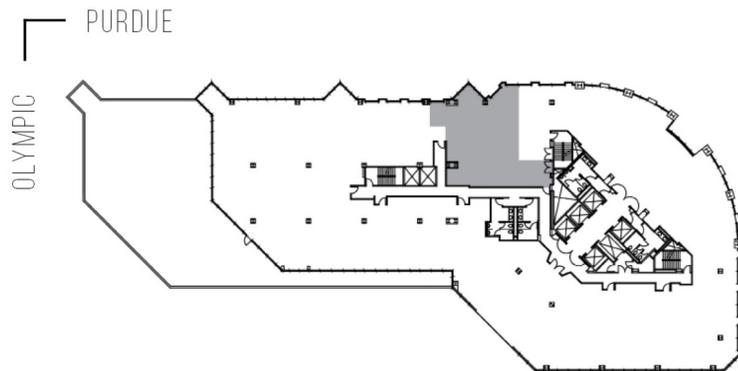


11400 W OLYMPIC

EXECUTIVE TOWER

SUITE 300 | 2,127 RSF

SAWTELLE/WEST LA

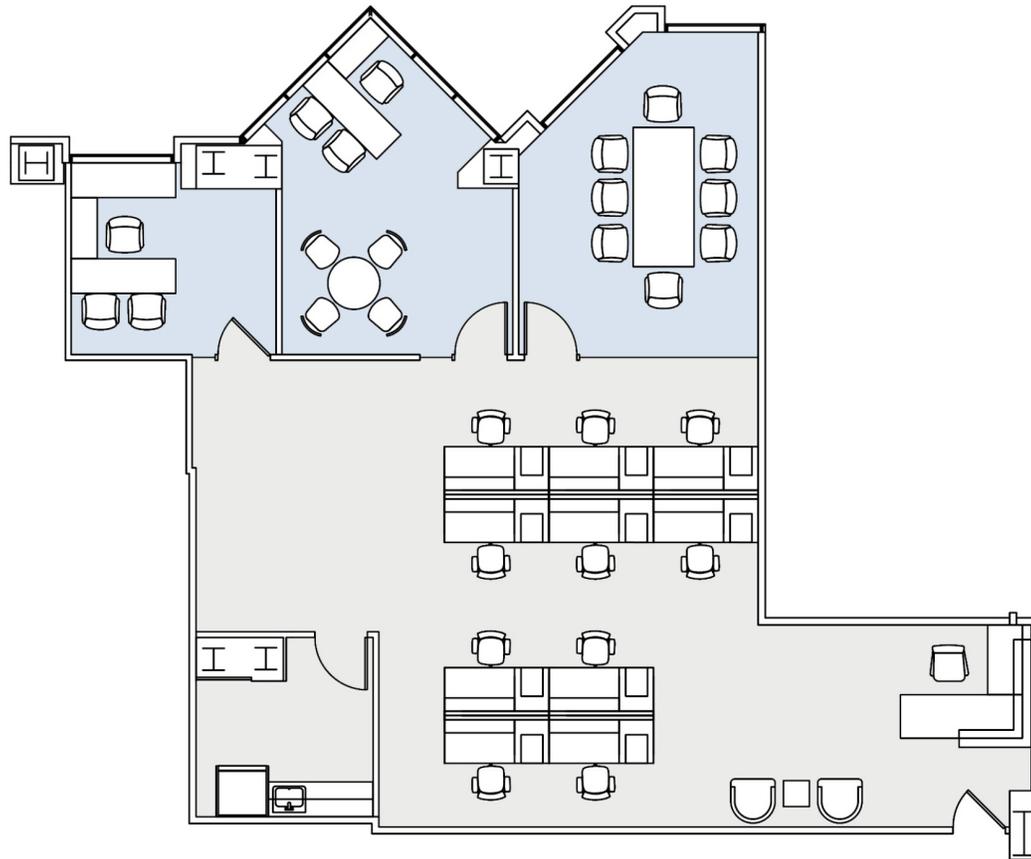

AS-BUILT CONFIGURATION

OFFICES:	2
KITCHEN :	1
CONFERENCE ROOM:	1
RECEPTION:	1

NOT TO SCALE
FURNITURE NOT INCLUDED

For more information, please contact:

310.255.7777
leasing@douglasemmett.com

**Douglas
Emmett**