


# 11835 OLYMPIC

WESTSIDE TOWERS EAST TOWER

SUITE 1135 | 1,324 RSF

SAWTELLE/WEST LA

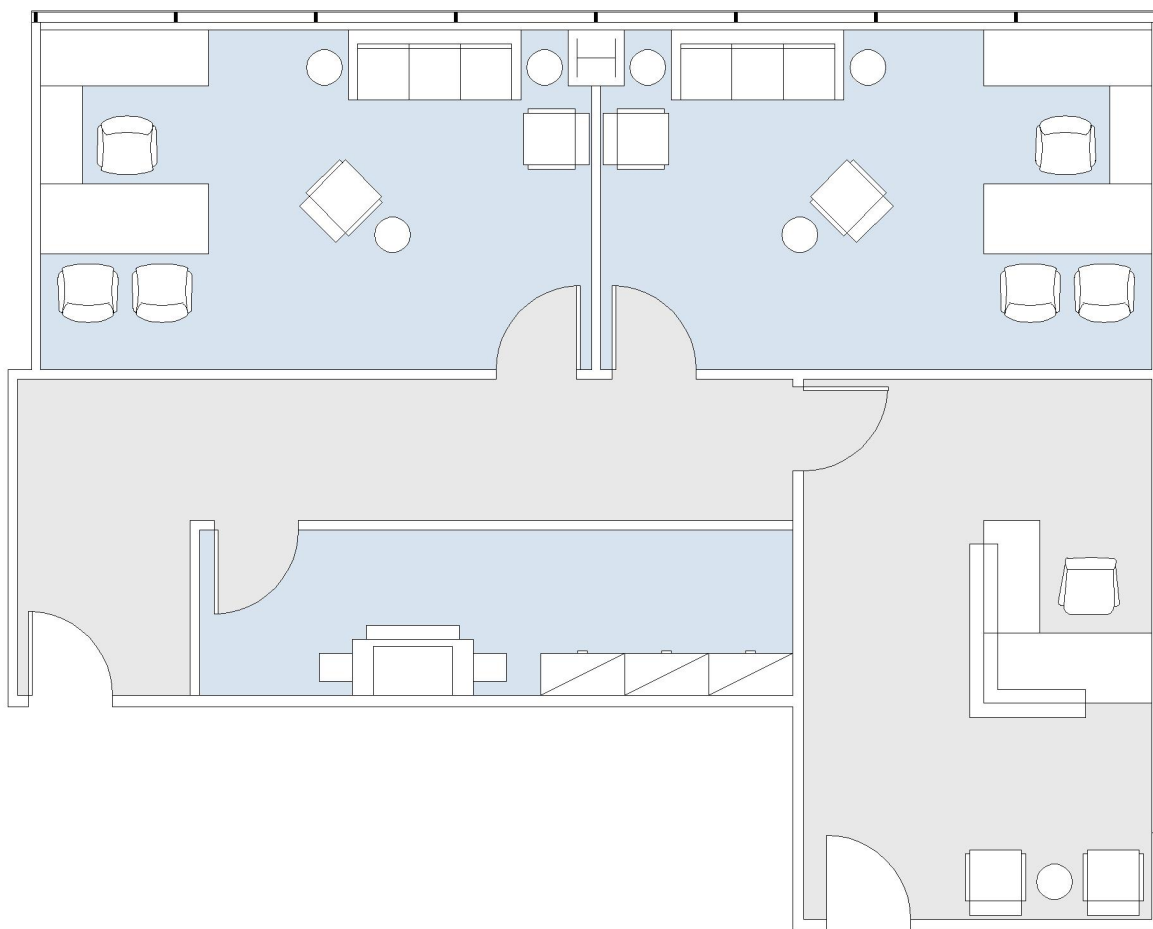


## AS-BUILT CONFIGURATION

|                      |   |
|----------------------|---|
| OFFICES:             | 2 |
| RECEPTION:           | 1 |
| COPY / STORAGE ROOM: | 1 |

NOT TO SCALE

FURNITURE NOT INCLUDED

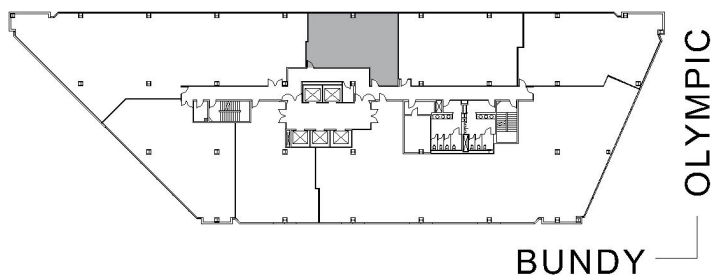

For more information, please contact:

310.255.7777  
leasing@douglasemmett.com

**Douglas  
Emmett**