



11400

EXECUTIVE TOWER

SUITE 840 | 1,148 RSF

SAWTELLE/WEST LA

W OLYMPIC

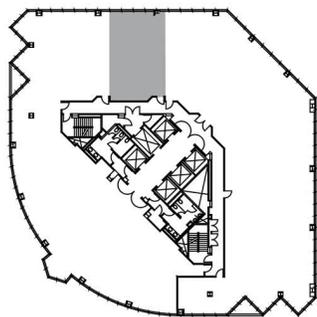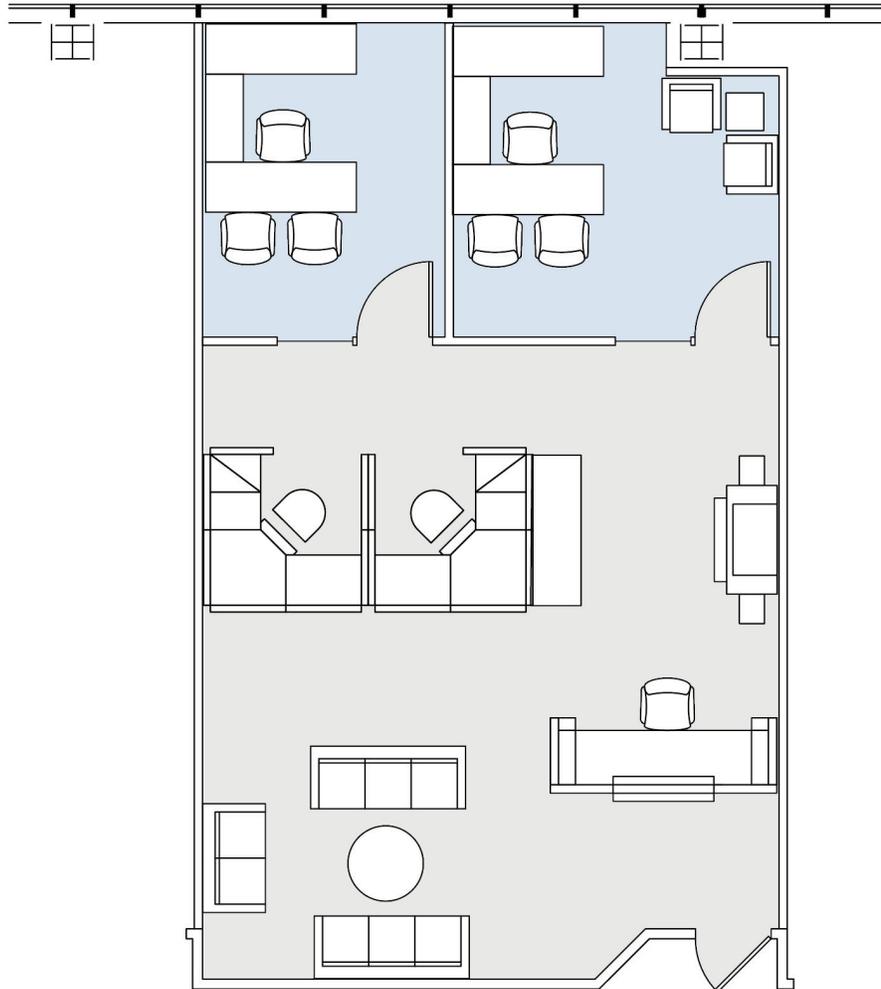

OLYMPIC
PURDUE

AS-BUILT CONFIGURATION

OFFICES:	2
RECEPTION AREA:	1

NOT TO SCALE
FURNITURE NOT INCLUDED

For more information, please contact:

310.255.7777
leasing@douglasemmett.com

**Douglas
Emmett**