



1990

CORNERSTONE PLAZA

SUITE 460 | 1,515 RSF

SAWTELLE/WEST LA

# SOUTH BUNDY

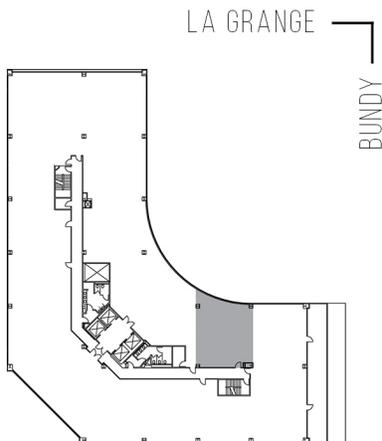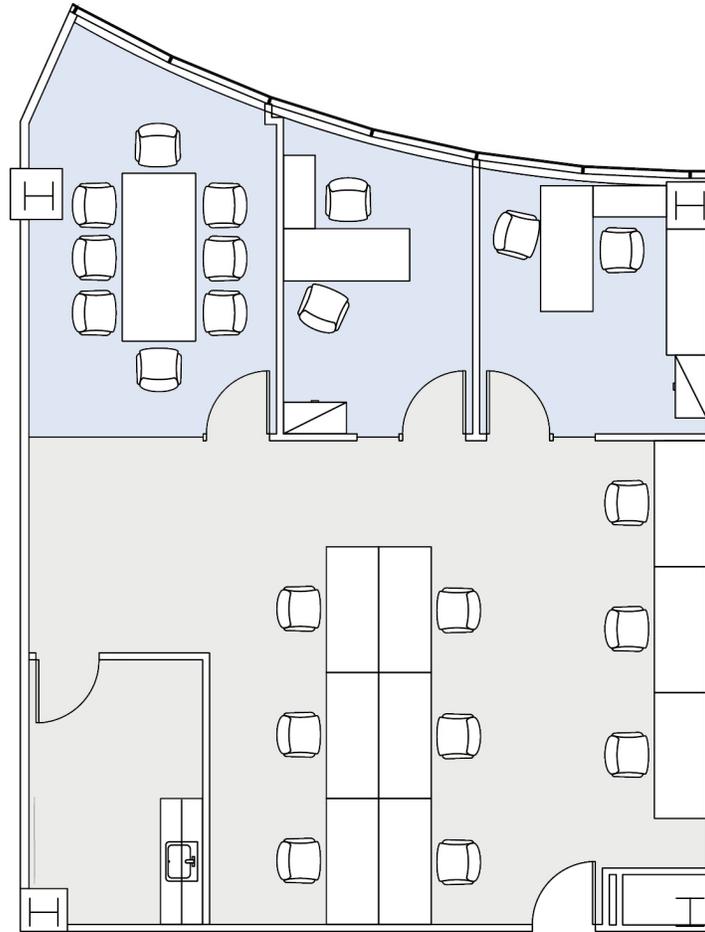

### AS-BUILT CONFIGURATION

OFFICE:	2
RECEPTION:	1
CONFERENCE ROOM:	1
KITCHEN:	1

NOT TO SCALE  
FURNITURE NOT INCLUDED

For more information, please contact:

310.255.7777  
leasing@douglasemmett.com

**Douglas  
Emmett**