


11726

SAN VICENTE

BRENTWOOD EXECUTIVE PLAZA


SUITE 290 | 877 RSF

BRENTWOOD-SAN VICENTE

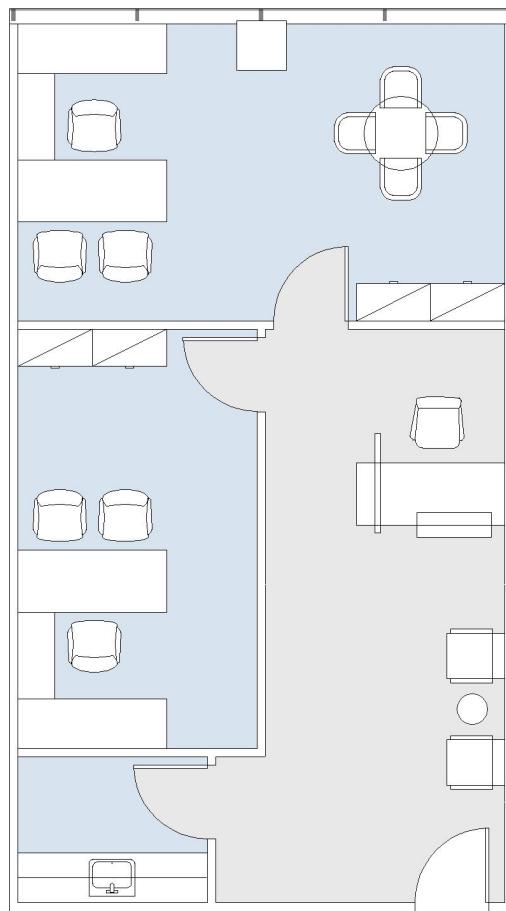

SAN VICENTE

BARRINGTON

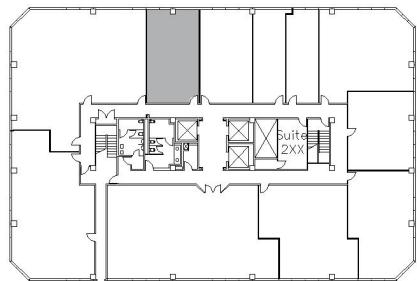

AS-BUILT CONFIGURATION

OFFICES:	2
RECEPTION:	1
KITCHEN:	1

NOT TO SCALE  
FURNITURE NOT INCLUDED

For more information, please contact:

310.255.7777

leasing@douglasemmett.com

**Douglas  
Emmett**