


10880


WILSHIRE

SUITE 915 | 1,655 RSF

WESTWOOD

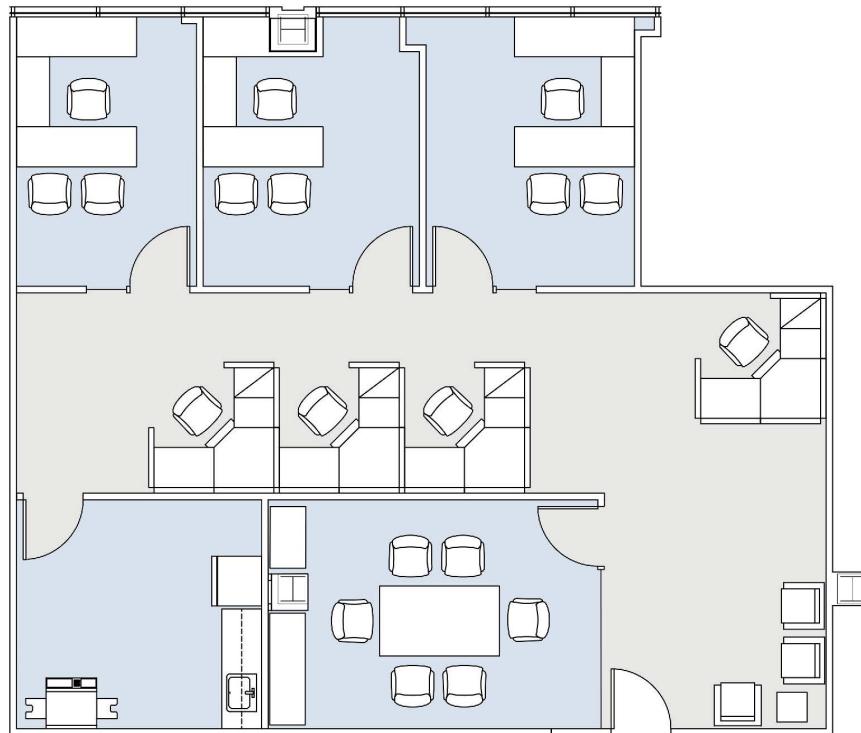

WILSHIRE
WESTWOOD

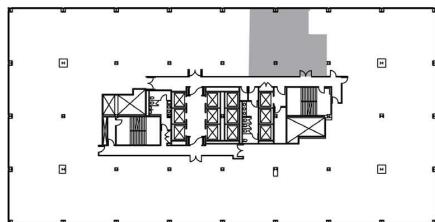

AS-BUILT CONFIGURATION

OFFICES:	3
WORKSTATIONS:	4
CONFERENCE ROOM:	1
KITCHEN:	1

NOT TO SCALE
FURNITURE NOT INCLUDED

For more information, please contact:

310.255.7777

leasing@douglasemmett.com

**Douglas
Emmett**