
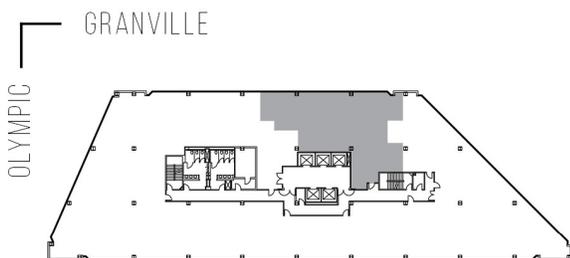


11835 OLYMPIC

WESTSIDE TOWERS EAST TOWER

SUITE 625 | 3,273 RSF

SAWTELLE/WEST LA

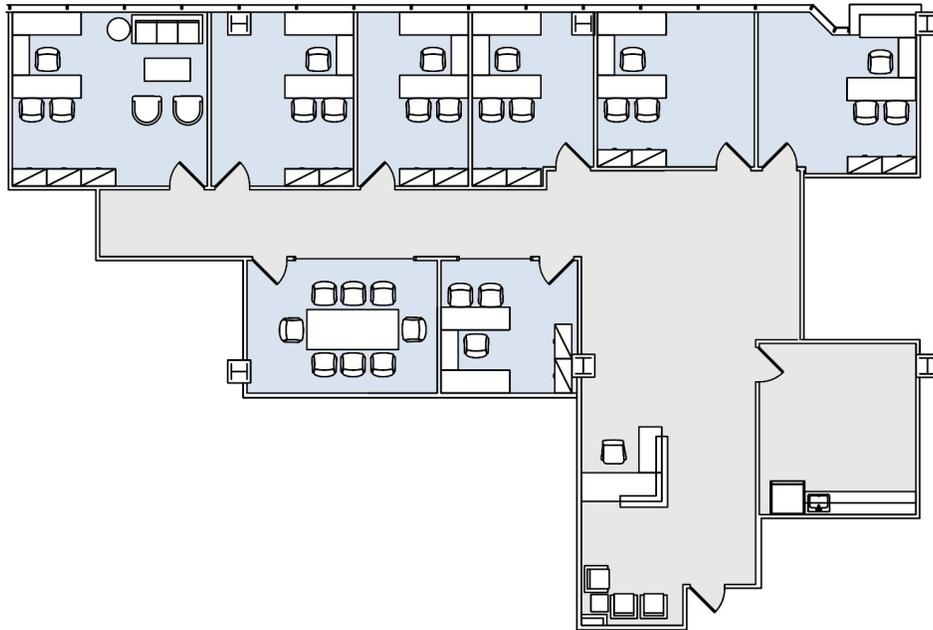

AS-BUILT CONFIGURATION

OFFICES:	7
CONFERENCE ROOM:	1
RECEPTION AREA:	1
KITCHEN:	1

NOT TO SCALE
FURNITURE NOT INCLUDED

For more information, please contact:

310.255.7777
leasing@douglasemmett.com

**Douglas
Emmett**