
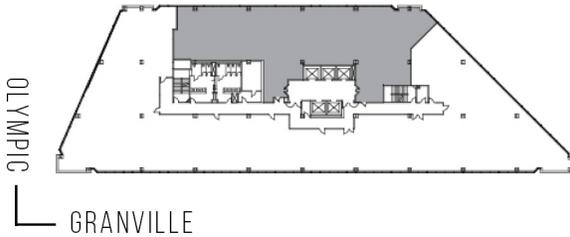


11835 OLYMPIC

WESTSIDE TOWERS EAST TOWER

SUITE 850 | 6,535 RSF

SAWTELLE/WEST LA

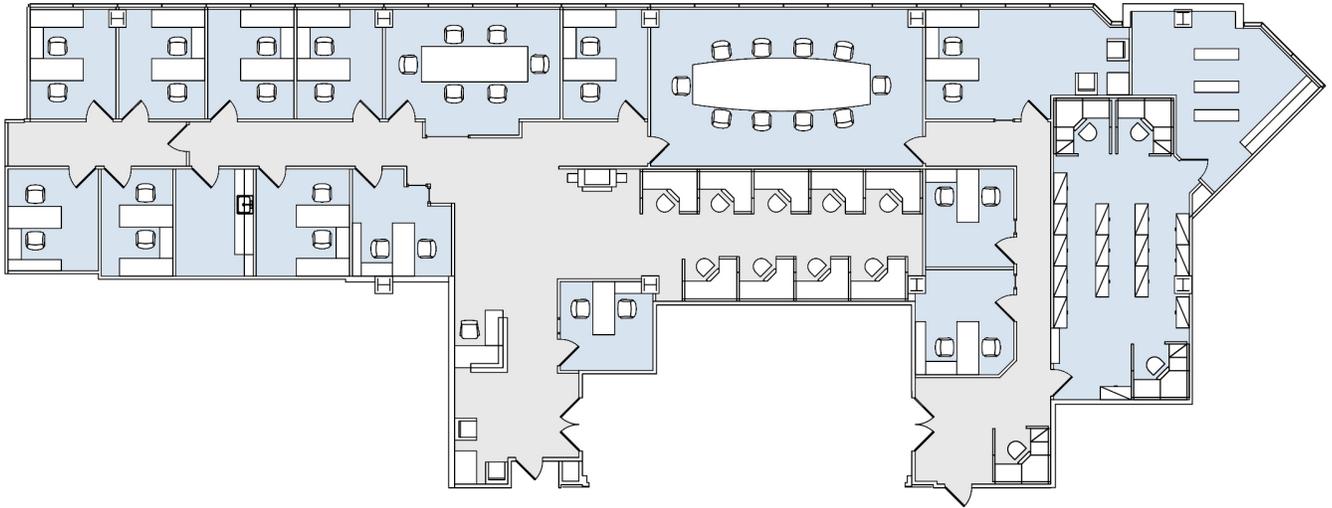

AS-BUILT CONFIGURATION

OFFICES:	13
CONFERENCE ROOM:	2
FILE ROOM:	1
RECEPTION:	1
IT ROOM:	1
KITCHEN:	1

ADJUSTED FOR SOCIAL DISTANCING
NOT TO SCALE
FURNITURE NOT INCLUDED

For more information, please contact:

310.255.7777
leasing@douglasemmett.com

**Douglas
Emmett**