



21700

WARNER CENTER TOWER - VI

SUITE 830 | 1,861 RSF

OXNARD STREET

WOODLAND HILLS

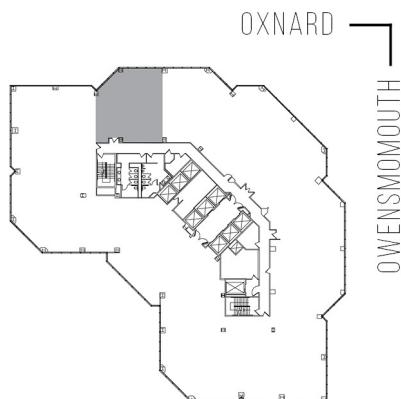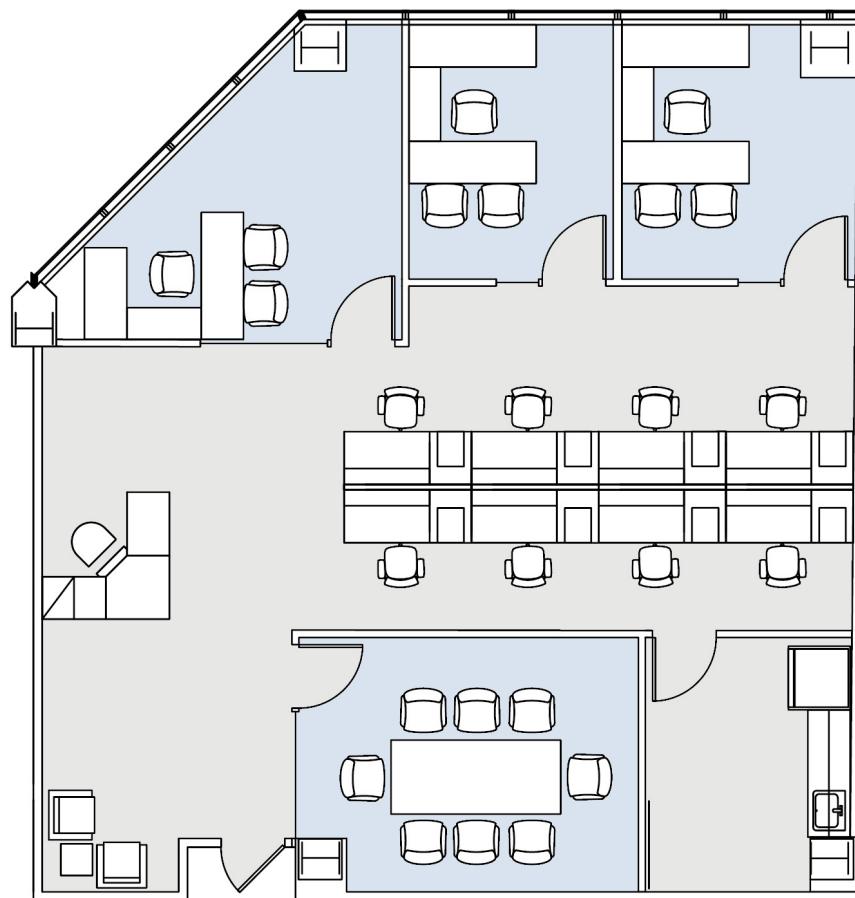

AS-BUILT CONFIGURATION

OFFICES:	3
CONFERENCE ROOM:	1
RECEPTION:	1
KITCHEN:	1

NOT TO SCALE  
FURNITURE NOT INCLUDED

For more information, please contact:

310.255.7777

leasing@douglasemmett.com

**Douglas  
Emmett**