


# 15260 VENTURA

VALLEY EXECUTIVE TOWER

SUITE 1140 | 2,671 RSF

SHERMAN OAKS/ENCINO

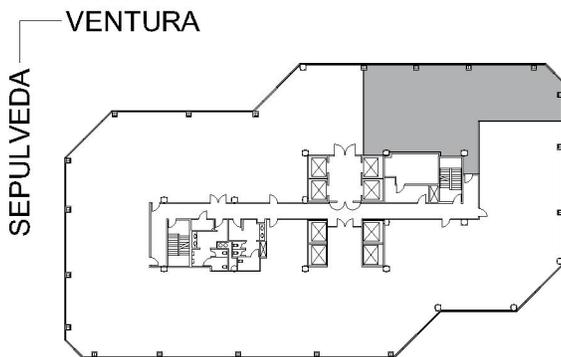

#### AS-BUILT CONFIGURATION

OFFICES:	5
CONFERENCE ROOM:	1
RECEPTION:	1
KITCHEN:	1
IT ROOM:	1

NOT TO SCALE  
FURNITURE NOT INCLUDED

For more information, please contact:

310.255.7777  
leasing@douglasemmett.com

**Douglas  
Emmett**