
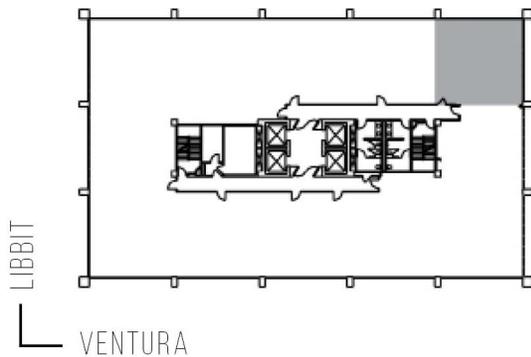


# 16255 VENTURA

MB PLAZA

SUITE 310 | 1,841 RSF

SHERMAN OAKS/ENCINO

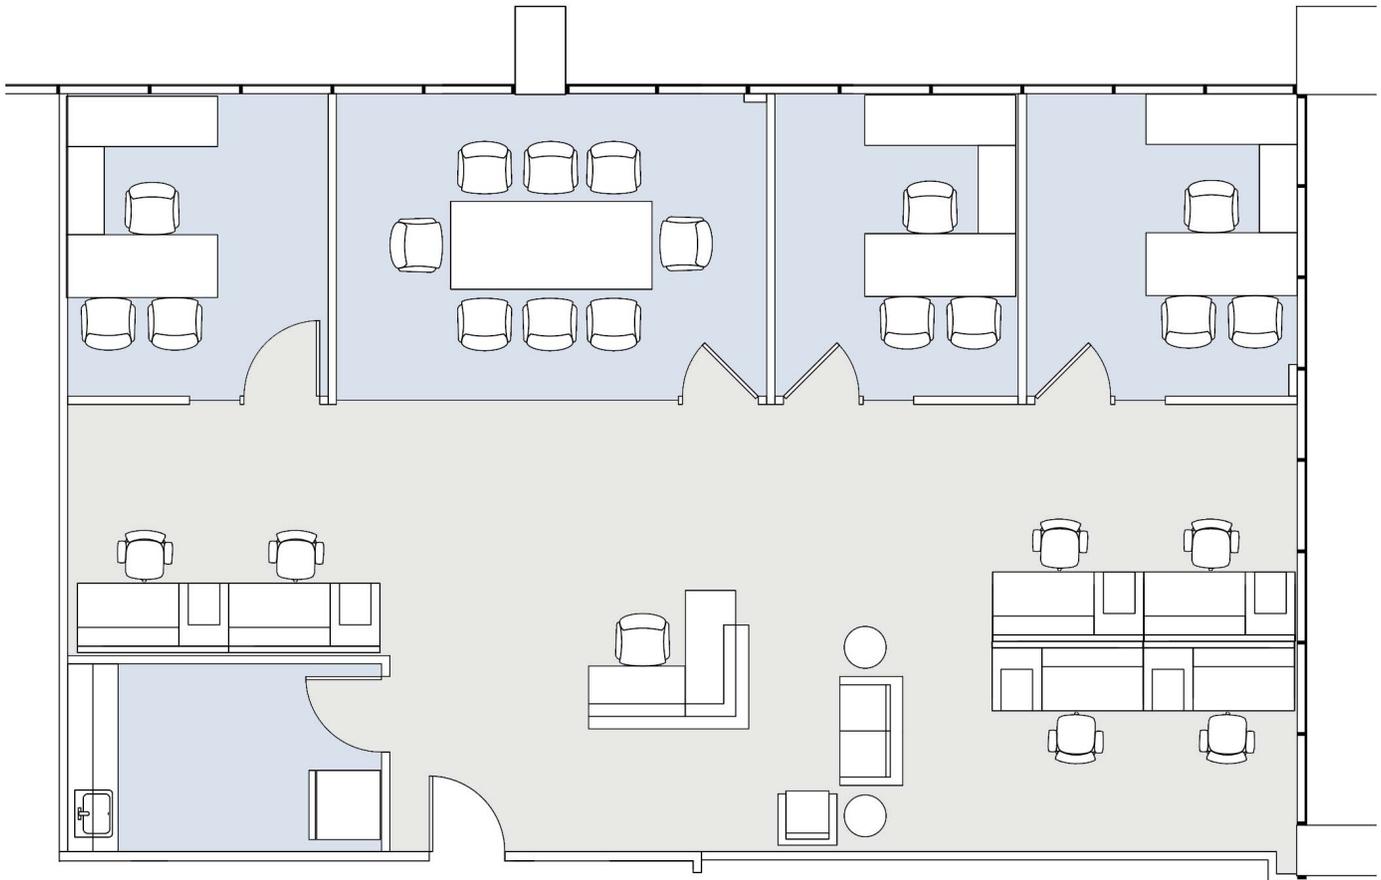

## AS-BUILT CONFIGURATION

OFFICES:	3
CONFERENCE ROOM:	1
RECEPTION:	1
KITCHEN:	1

NOT TO SCALE  
FURNITURE NOT INCLUDED

For more information, please contact:

310.255.7777  
leasing@douglasemmett.com

**Douglas  
Emmett**