



6320

THE TRILLIUM - EAST TOWER

SUITE 910 | 2,234 RSF

WOODLAND HILLS

CANOGA AVENUE

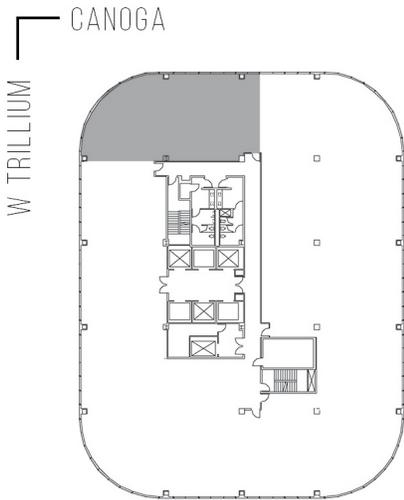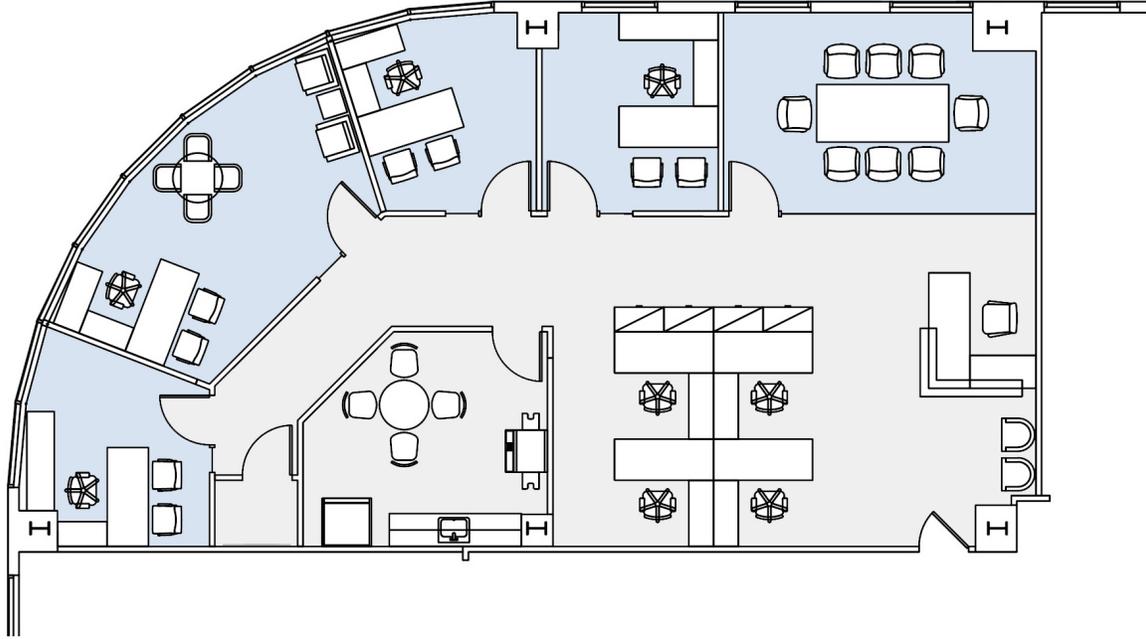

AS-BUILT CONFIGURATION

OFFICES:	4
CONFERENCE ROOM:	1
KITCHEN:	1
STORAGE CLOSET:	1

NOT TO SCALE
FURNITURE NOT INCLUDED

For more information, please contact:

310.255.7777
leasing@douglasemmett.com

