
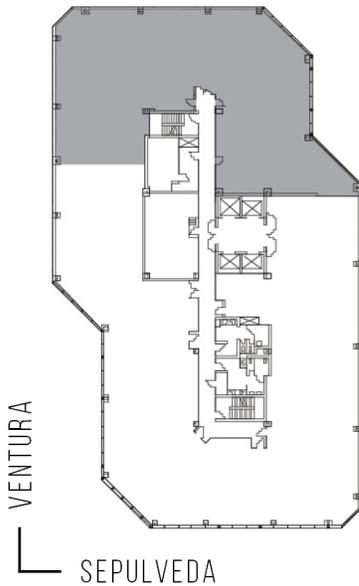


15260 VENTURA

VALLEY EXECUTIVE TOWER

SUITE 1440 | 6,263 RSF

SHERMAN OAKS/ENCINO

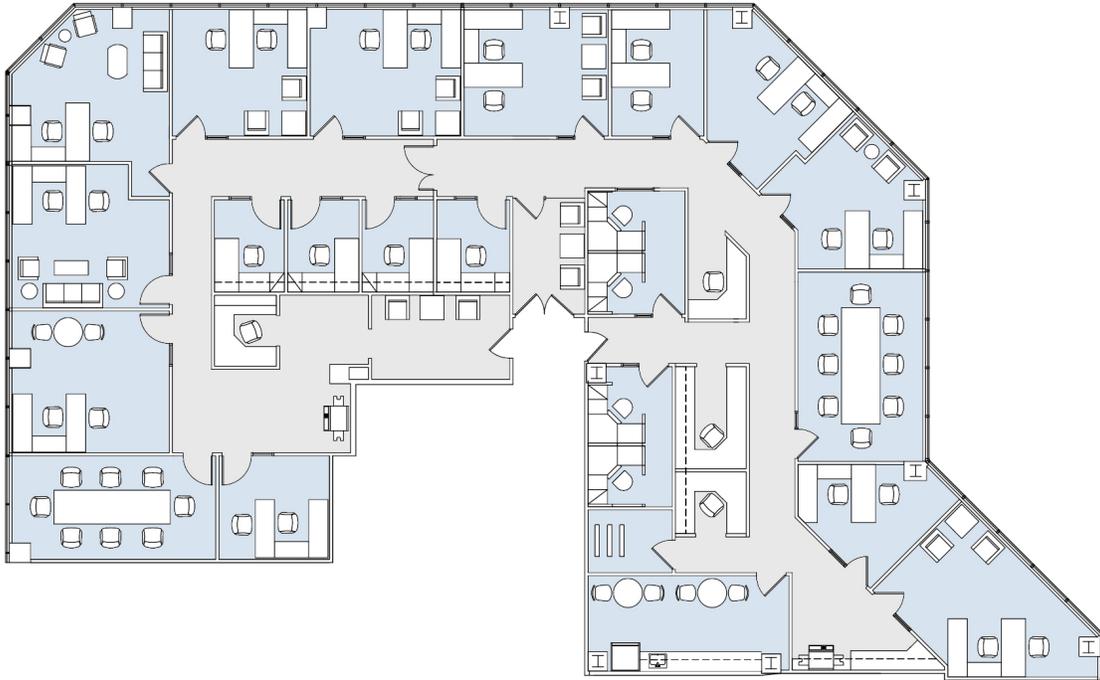

AS-BUILT CONFIGURATION

OFFICES:	18
CONFERENCE ROOMS:	2
RECEPTION:	1
KITCHEN:	1
I.T. ROOM:	1

ADJUSTED FOR SOCIAL DISTANCING
NOT TO SCALE
FURNITURE NOT INCLUDED

For more information, please contact:

310.255.7777
leasing@douglasemmett.com

**Douglas
Emmett**