


120

PALISADES PROMENADE

SUITE 400 | 14,437 RSF

SANTA MONICA

BROADWAY

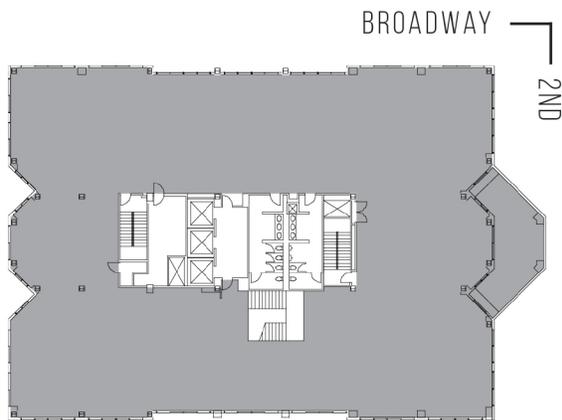

AS-BUILT CONFIGURATION

OFFICES:	38
CONFERENCE ROOMS:	3
KITCHEN/ BREAK ROOM:	1
I.T. ROOM:	1
STORAGE ROOM:	1
COPY/ FILE ROOM:	1
RESTROOMS:	2
SHOWER:	1

ADJUSTED FOR SOCIAL DISTANCING
NOT TO SCALE
FURNITURE NOT INCLUDED

For more information, please contact:

310.255.7777
leasing@douglasemmett.com

**Douglas
Emmett**