



530

VERONA

SUITE 109 | 1,465 RSF

SANTA MONICA

WILSHIRE

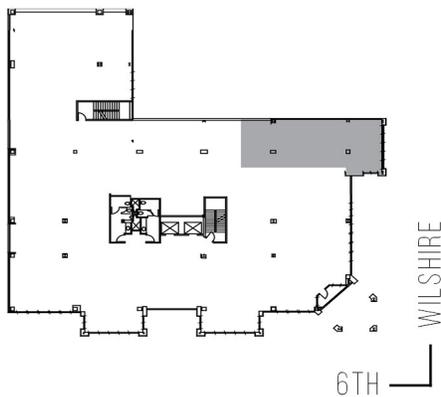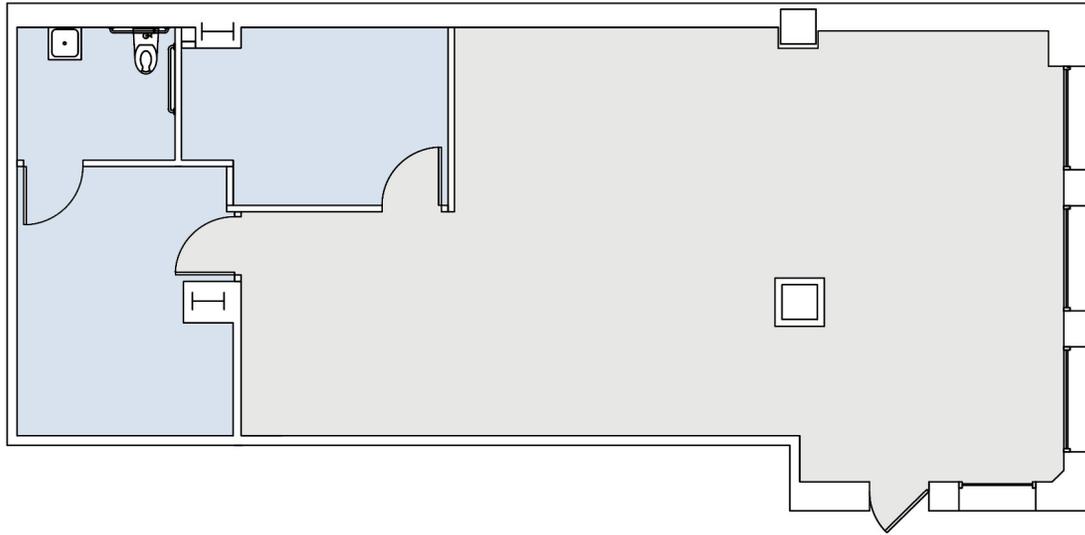

AS-BUILT CONFIGURATION

OFFICE:	1
STORAGE ROOM:	1
RESTROOM:	1

NOT TO SCALE
FURNITURE NOT INCLUDED

For more information, please contact:

310.255.7777
leasing@douglasemmett.com

**Douglas
Emmett**