
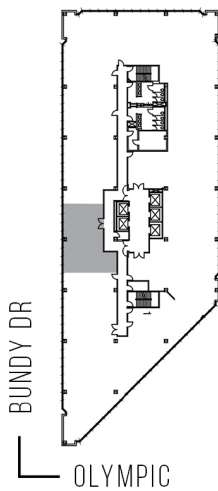


11845 OLYMPIC

WESTSIDE TOWERS WEST TOWER

SUITE 1042 | 1,184 RSF

SAWTELLE/WEST LA

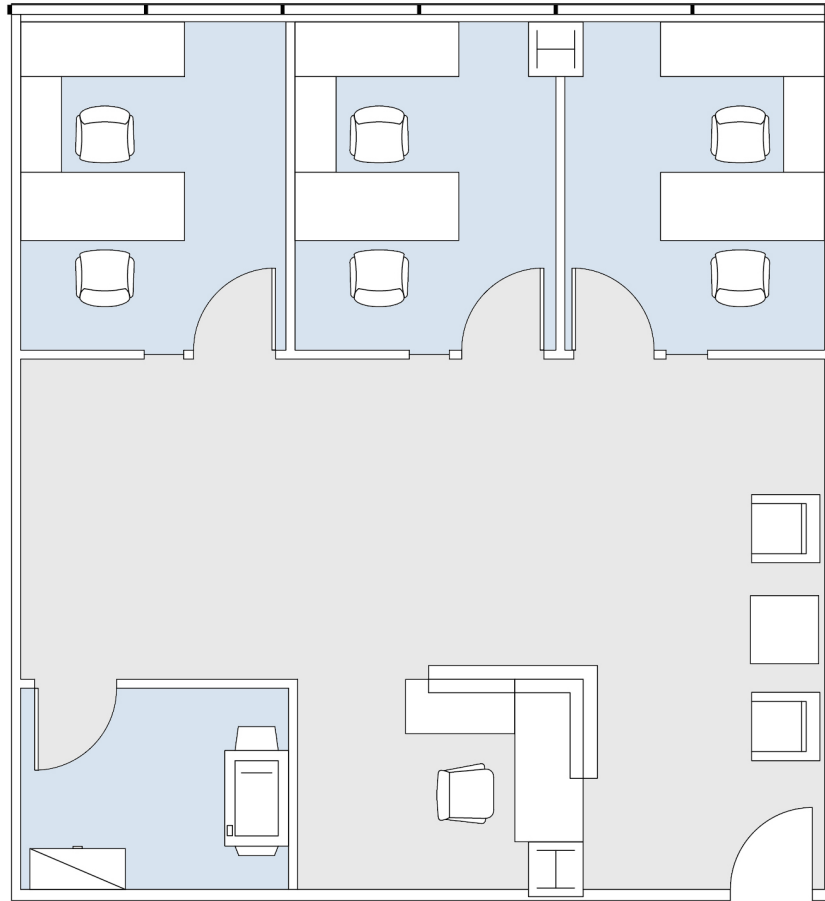

AS-BUILT CONFIGURATION

OFFICES:	3
RECEPTION:	1
STORAGE ROOM:	1

ADJUSTED FOR SOCIAL DISTANCING
NOT TO SCALE
FURNITURE NOT INCLUDED

For more information, please contact:

310.255.7777
leasing@douglasemmett.com

**Douglas
Emmett**